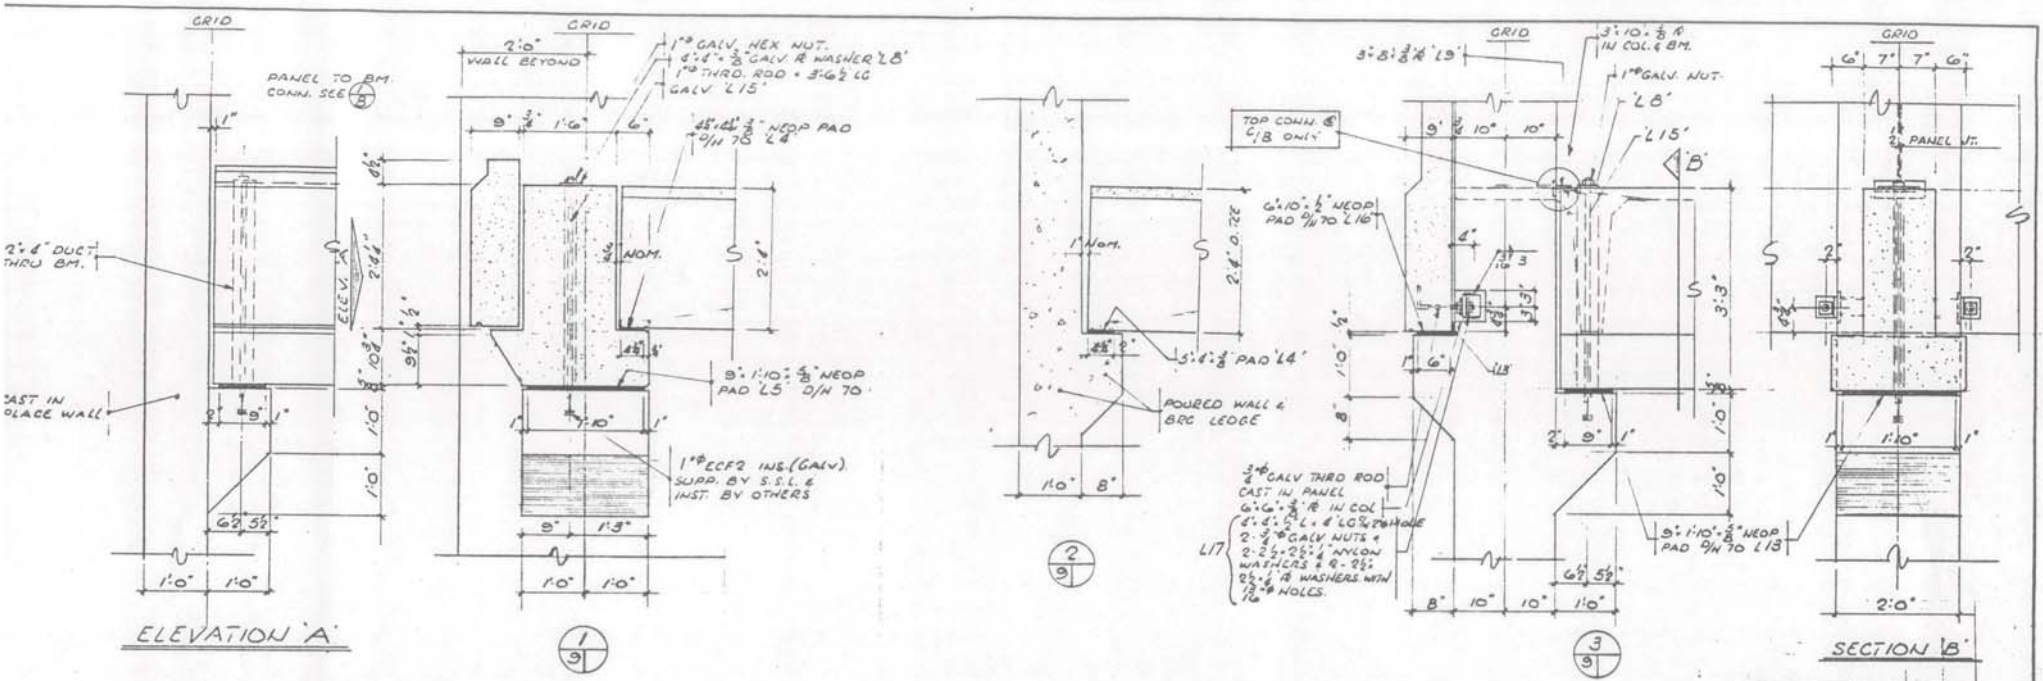

RECEIVED
FEB 24
MARSHALL MACKLIN MONAGHAN LIMITED

3905

ISSUED	#	REV. No.	DESCRIPTION	CHECK
80.03.14	#3	-	ERECTION	TL
80.02.26	#2	GEN	RECORDS / JOBSITE	TL
80.02.06	#2	GEN	APPR.	TL
80.01.02	#1	-	APPROVAL	TL

STANLEY
Stanley Structures Limited
Belleville (613) 962-4567

JOB: NORTH YORK GENERAL HOSPITAL PARKING DECK

DETAIL: SECTIONS

DETAIL NO. | DRN BY: TL | CHK: I.C. | DATE: JAN. 80
CHECKED BY | REVISION
DETAIL REFERENCE SHEET NO. SHEET NO.
DRAWING NO. D-3469-9

I. COHEN
REGISTERED PROFESSIONAL ENGINEER PROVINCE OF ONTARIO

PRECAST CONCRETE COMPONENTS AND THEIR CONNECTIONS AS SUPPLIED BY STANLEY STRUCTURES LIMITED ONLY

APPROVED
15 APR 80
CONSTRUCTION

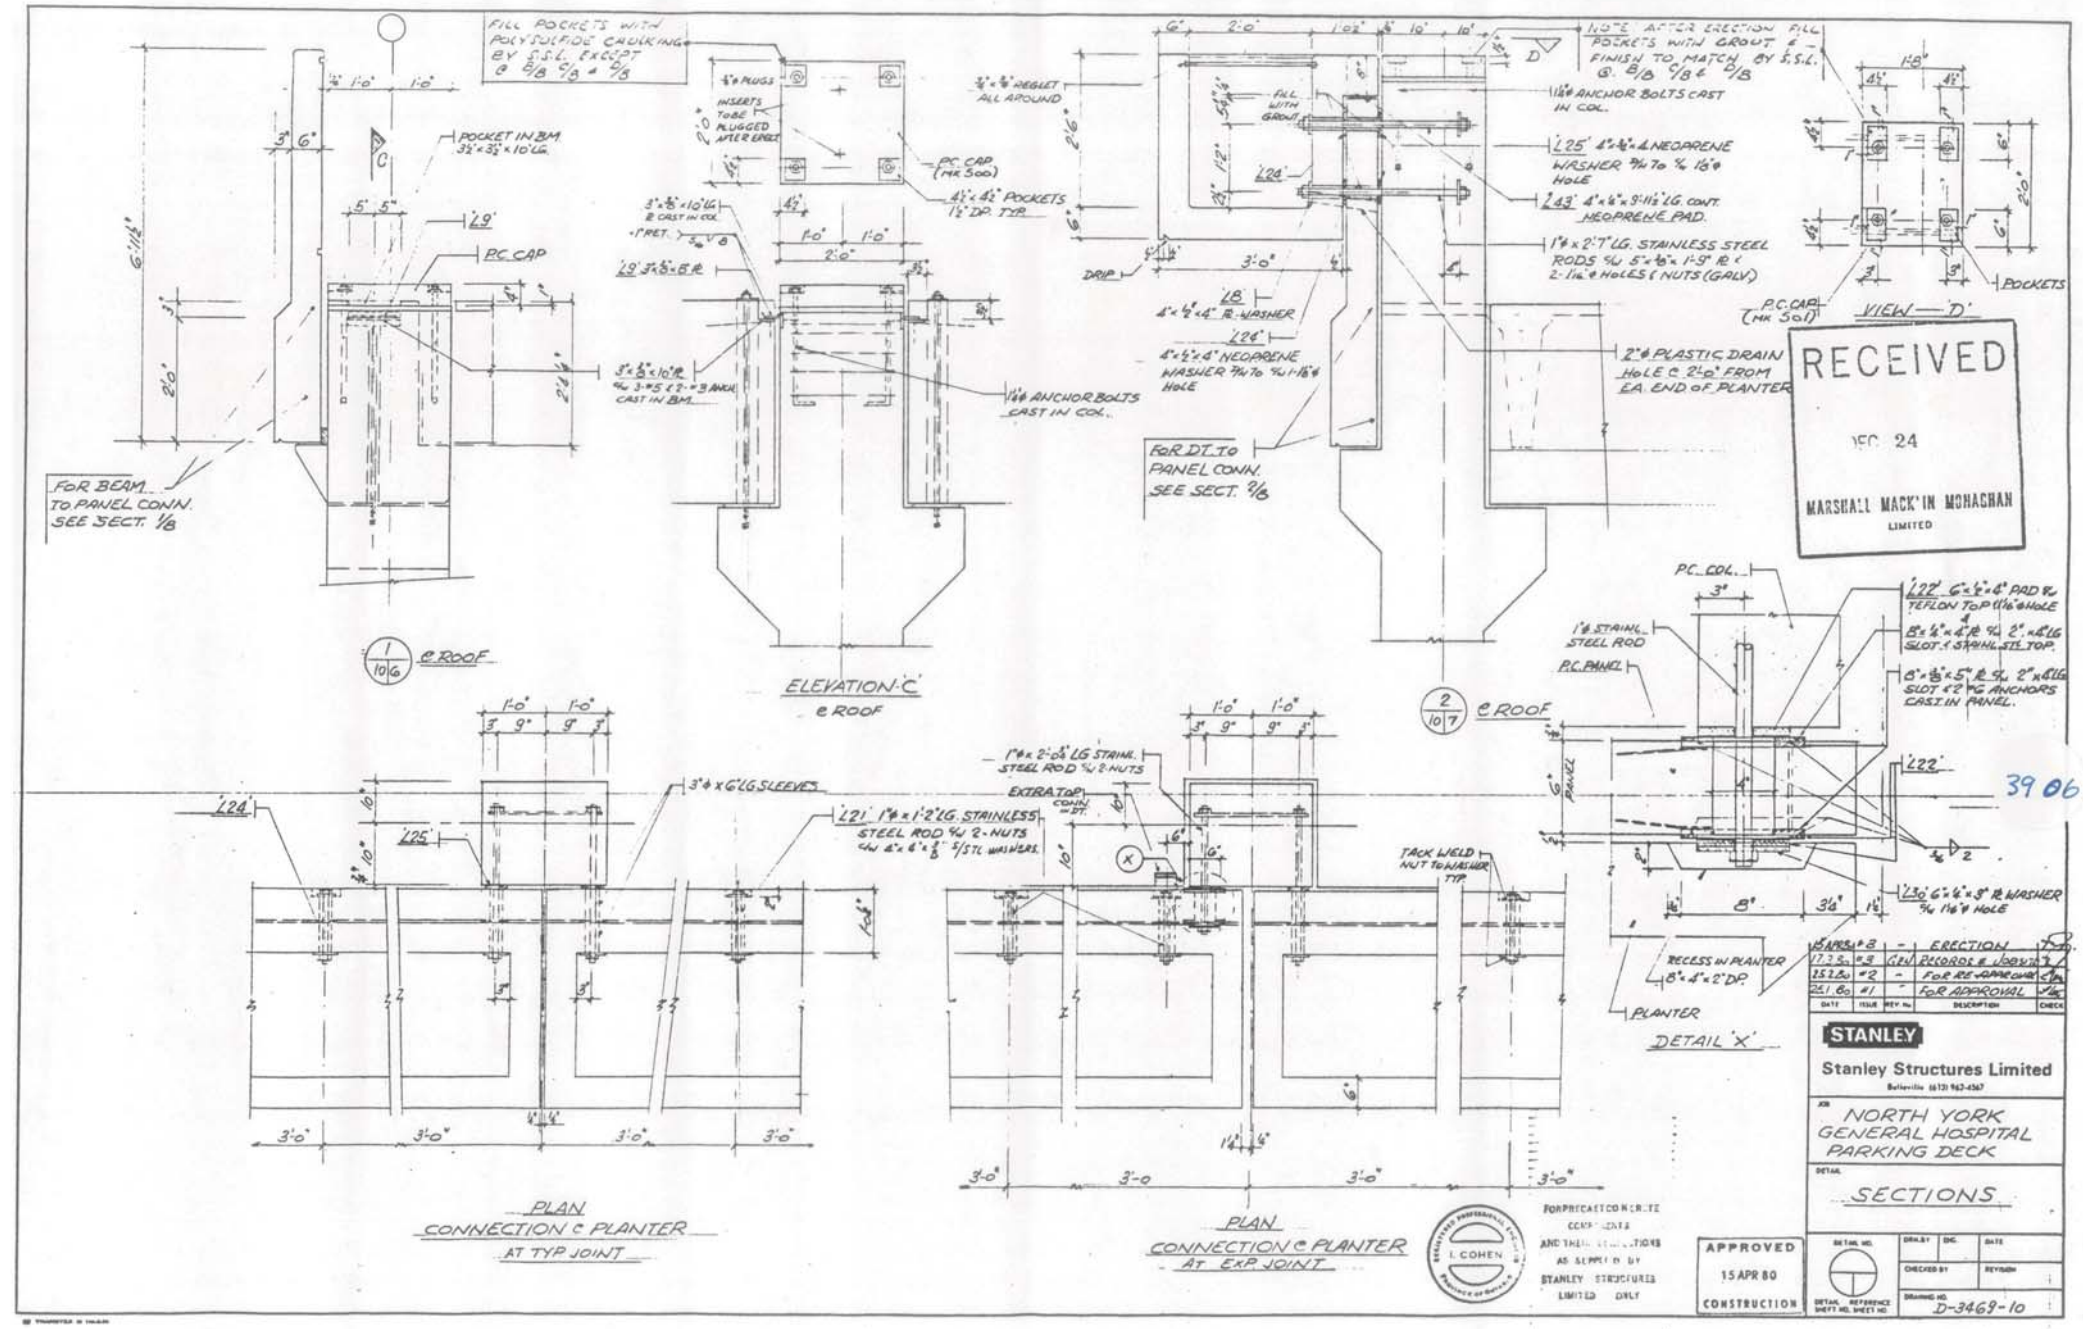

3906

DATE	ISSUE	REV. No.	DESCRIPTION	CHECK
15 APR 80	#3	-	ERECTION	
17 JAN 80	#2	-	GEN. RECORDS & JOB NO.	
25 FEB 80	#2	-	FOR RE-APPROVAL	
24 JAN 80	#1	-	FOR APPROVAL	

STANLEY

Stanley Structures Limited
Belleville (613) 962-4567

JOB NORTH YORK GENERAL HOSPITAL PARKING DECK

DETAIL SECTIONS

APPROVED 15 APR 80 CONSTRUCTION

DETAIL NO. | DETAIL REFERENCE SHEET NO. | SHEET NO.

DRN.BY | CHK. | DATE
CHECKED BY | REVISION

DRAWING NO. D-3469-10

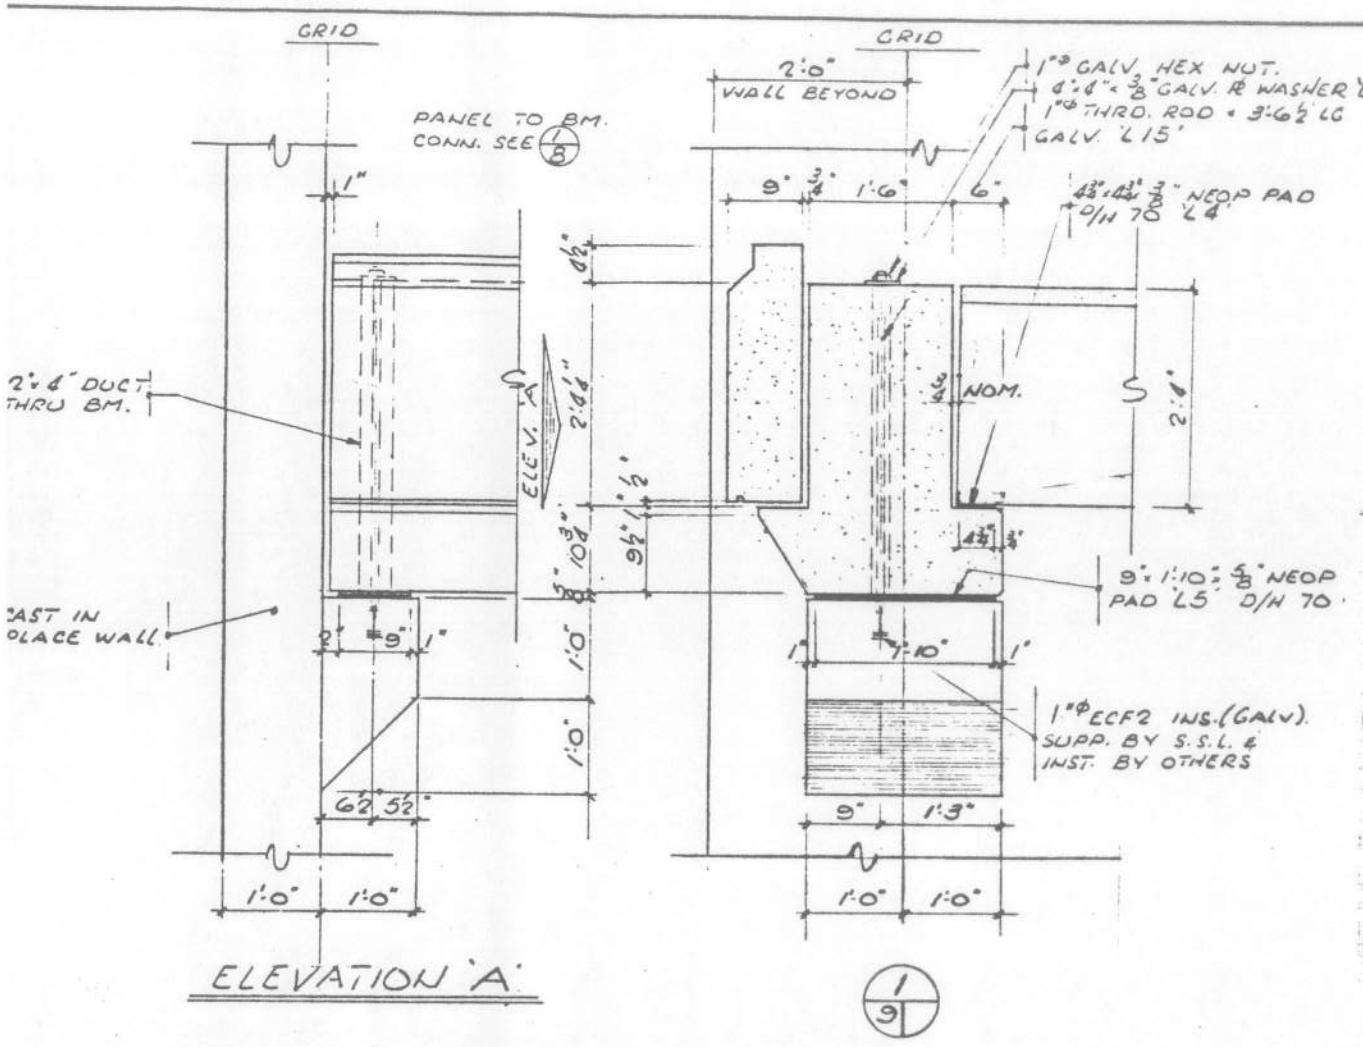

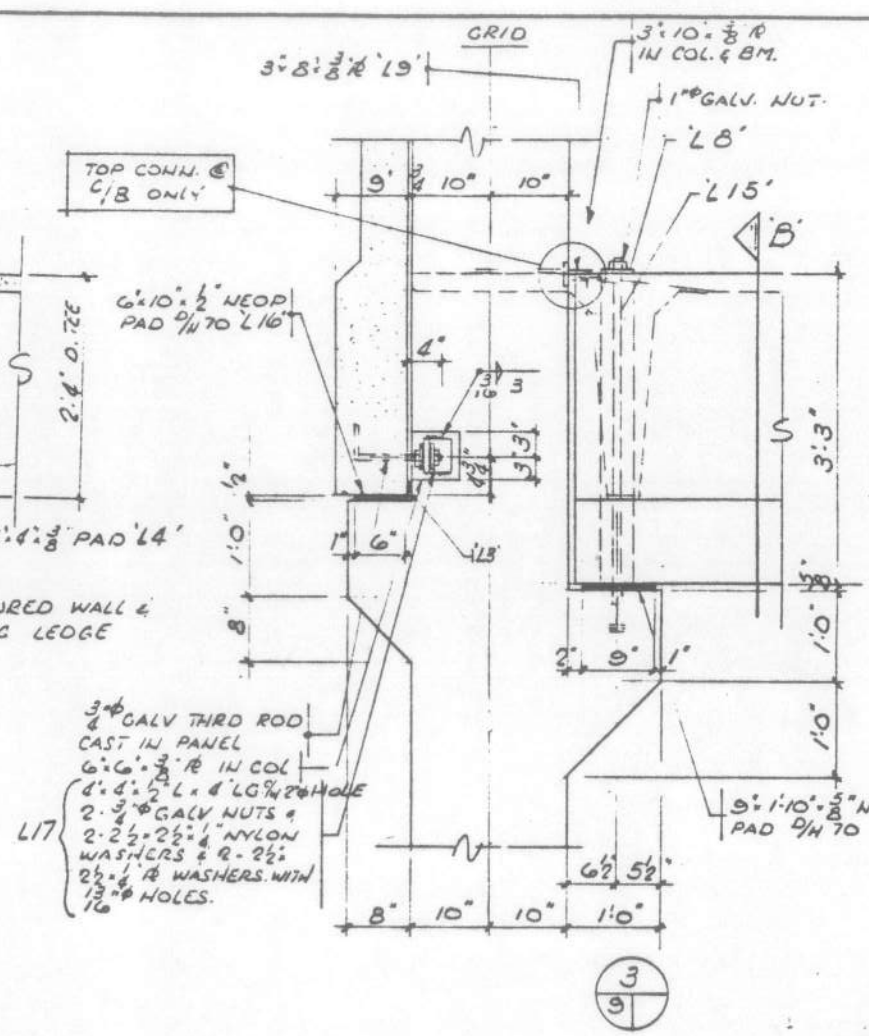

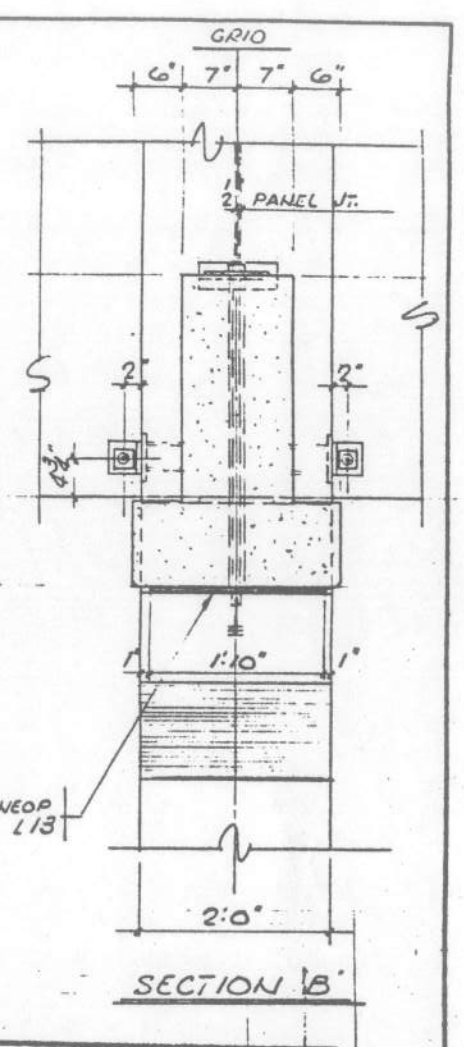

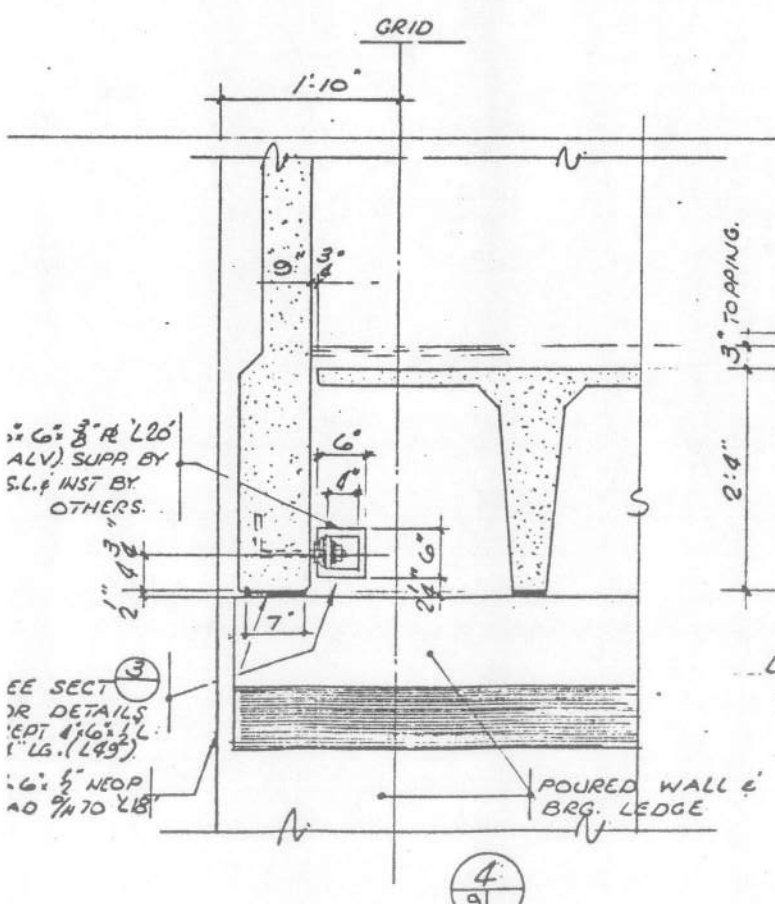

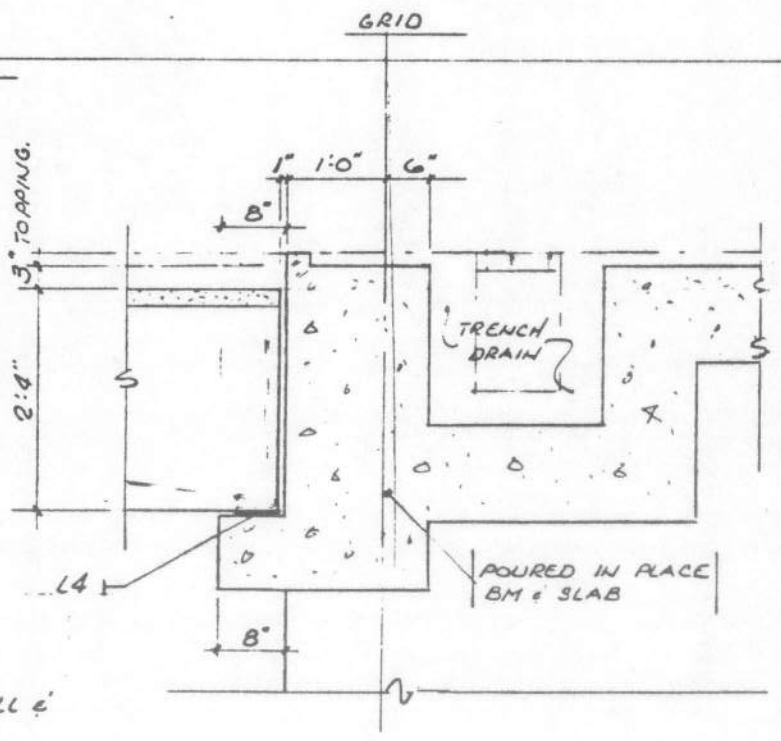

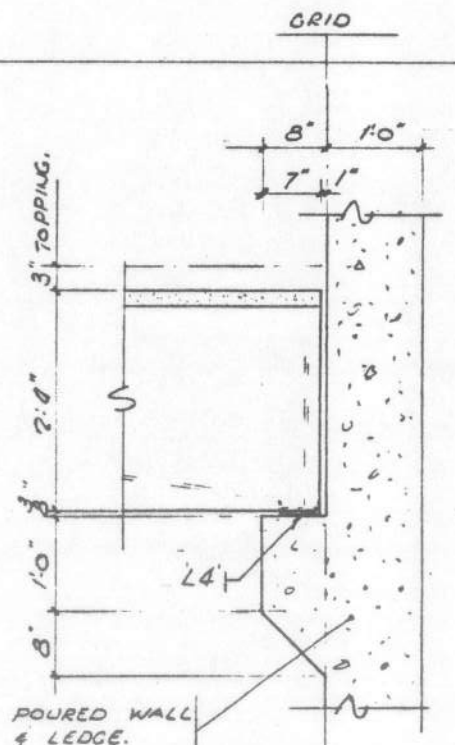

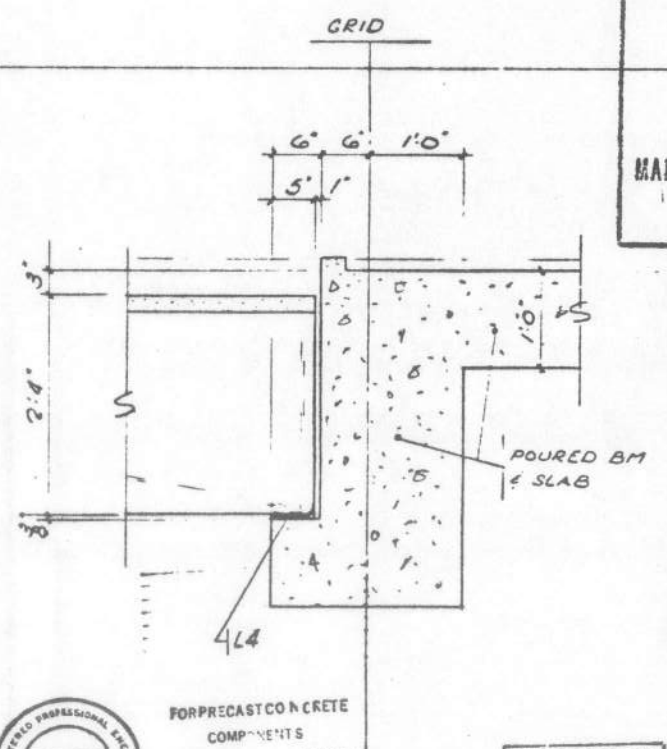

I. COHEN
REGISTERED PROFESSIONAL ENGINEER
PROVINCE OF ONTARIO

FOR PRECAST CONCRETE COMPONENTS AND THEIR CONNECTIONS AS SUPPLIED BY STANLEY STRUCTURES LIMITED ONLY

APPROVED
15 APR 80
CONSTRUCTION

RECEIVED
FP. 24
MARSHALL MACKLIN MONAGHAN LIMITED

3905

DATE	ISSUE	REV. No.	DESCRIPTION	CHECK
15APR80	#3	-	ERECTION	TC
17.3.80	#2	GEN	RECORDS & JOBSITE	TC
25.2.80	#2	GEN	APPR.	TC
25.1.80	#1	-	APPROVAL	CHK

STANLEY
Stanley Structures Limited
Belleville (613) 962-4567

JOB: NORTH YORK GENERAL HOSPITAL PARKING DECK

DETAIL: SECTIONS

DETAIL NO. | DRN. BY TC | ENG. I.C. | DATE JAN. 80
CHECKED BY | REVISION
DETAIL REFERENCE SHEET NO. SHEET NO.
DRAWING NO. D-3469-9

FILL POCKETS WITH POLYSULFIDE CAULKING BY S.S.L. EXCEPT @ B/8 C/8 & D/8

POCKET IN BM. 3½"x3½"x10" LG.

L29

PC CAP

FOR BEAM TO PANEL CONN. SEE SECT. 1/8

1/10/6 ℄ ROOF

ELEVATION 'C' ℄ ROOF

¾"ϕ PLUGS

INSERTS TO BE PLUGGED AFTER ERECT

PC CAP (MK 500)

4½"x4½" POCKETS 1½" DP. TYP.

3"x⅜"x10" LG 2 CAST IN COL.

1" RET.

L29 3"x⅜"x6" R

3"x⅜"x10" R ¾ W 3-#5 & 2-#3 ANCH. CAST IN BM.

1¼ϕ ANCHOR BOLTS CAST IN COL.

¾"x¾" REGLET ALL AROUND

FILL WITH GROUT

L24

L25" 4"x3½"x¼ NEOPRENE WASHER ⅞W TO ⅞W 1⅛ϕ HOLE

L43 4"x⅛"x9'-11½" LG CONT. NEOPRENE PAD.

1"ϕ x 2'-7" LG. STAINLESS STEEL RODS ⅝W 5"x⅜"x 1'-9" R < 2-1/16"ϕ HOLES & NUTS (GALV.)

DRIP

L8 4"x½"x4" R. WASHER

L24 4"x½"x4" NEOPRENE WASHER ⅞W TO ⅞W 1-1⅛ϕ HOLE

FOR DT. TO PANEL CONN. SEE SECT. 2/8

2"ϕ PLASTIC DRAIN HOLE @ 2'-0" FROM EA. END OF PLANTER

NOTE: AFTER ERECTION FILL POCKETS WITH GROUT & FINISH TO MATCH BY S.S.L. @ B/8 C/8 & D/8

1⅛ϕ ANCHOR BOLTS CAST IN COL.

POCKETS

P.C. CAP (MK 501)

VIEW 'D'

RECEIVED

DEC 24

MARSHALL MACKLIN MONAGHAN LIMITED

P.C. COL.

L22 6"x½"x4" PAD ⅝W TEFLON TOP 1-1/16"ϕ HOLE

8"x¼"x4" R ⅝W 2"x4" LG SLOT & STAINL. STL. TOP.

8"x⅜"x5" R ⅝W 2"x8" LG SLOT & 2 PG ANCHORS CAST IN PANEL.

1"ϕ STAINL. STEEL ROD

P.C. PANEL

2/10/7 ℄ ROOF

L30 6"x¼"x3" R WASHER ⅝W 1/16"ϕ HOLE

RECESS IN PLANTER 8"x4"x2" DP.

PLANTER

DETAIL 'X'

3906

L24

L25

3"ϕ x 6' LG SLEEVES

L21 1"ϕ x 1'-2" LG. STAINLESS STEEL ROD ⅝W 2-NUTS ⅝W 4"x6"x⅜" S/STL WASHERS.

PLAN CONNECTION ℄ PLANTER AT TYP JOINT

1"ϕ x 2'-0⅝" LG STAINL. STEEL ROD ⅝W 2-NUTS

EXTRA TOP CONN. IN DT.

TACK WELD NUT TO WASHER TYP.

PLAN CONNECTION ℄ PLANTER AT EXP JOINT

DATE	ISSUE	REV. No	DESCRIPTION	CHECK
15 APR 80	#3	-	ERECTION	
17.3.80	#3	(2)	RECORDS & JOB NO.	
25.2.80	#2	-	FOR RE-APPROVAL	
25.1.80	#1	-	FOR APPROVAL	

STANLEY

Stanley Structures Limited

Belleville (613) 962-4567

JOB: NORTH YORK GENERAL HOSPITAL PARKING DECK

DETAIL: SECTIONS

DETAIL NO. | DRN. BY | ENG. | DATE | CHECKED BY | REVISION | DRAWING NO. D-3469-10

DETAIL REFERENCE SHEET NO. SHEET NO.

I. COHEN REGISTERED PROFESSIONAL ENGINEER PROVINCE OF ONTARIO

FOR PRECAST CONCRETE COMPONENTS AND THEIR CONNECTIONS AS SUPPLIED BY STANLEY STRUCTURES LIMITED ONLY

APPROVED 15 APR 80 CONSTRUCTION

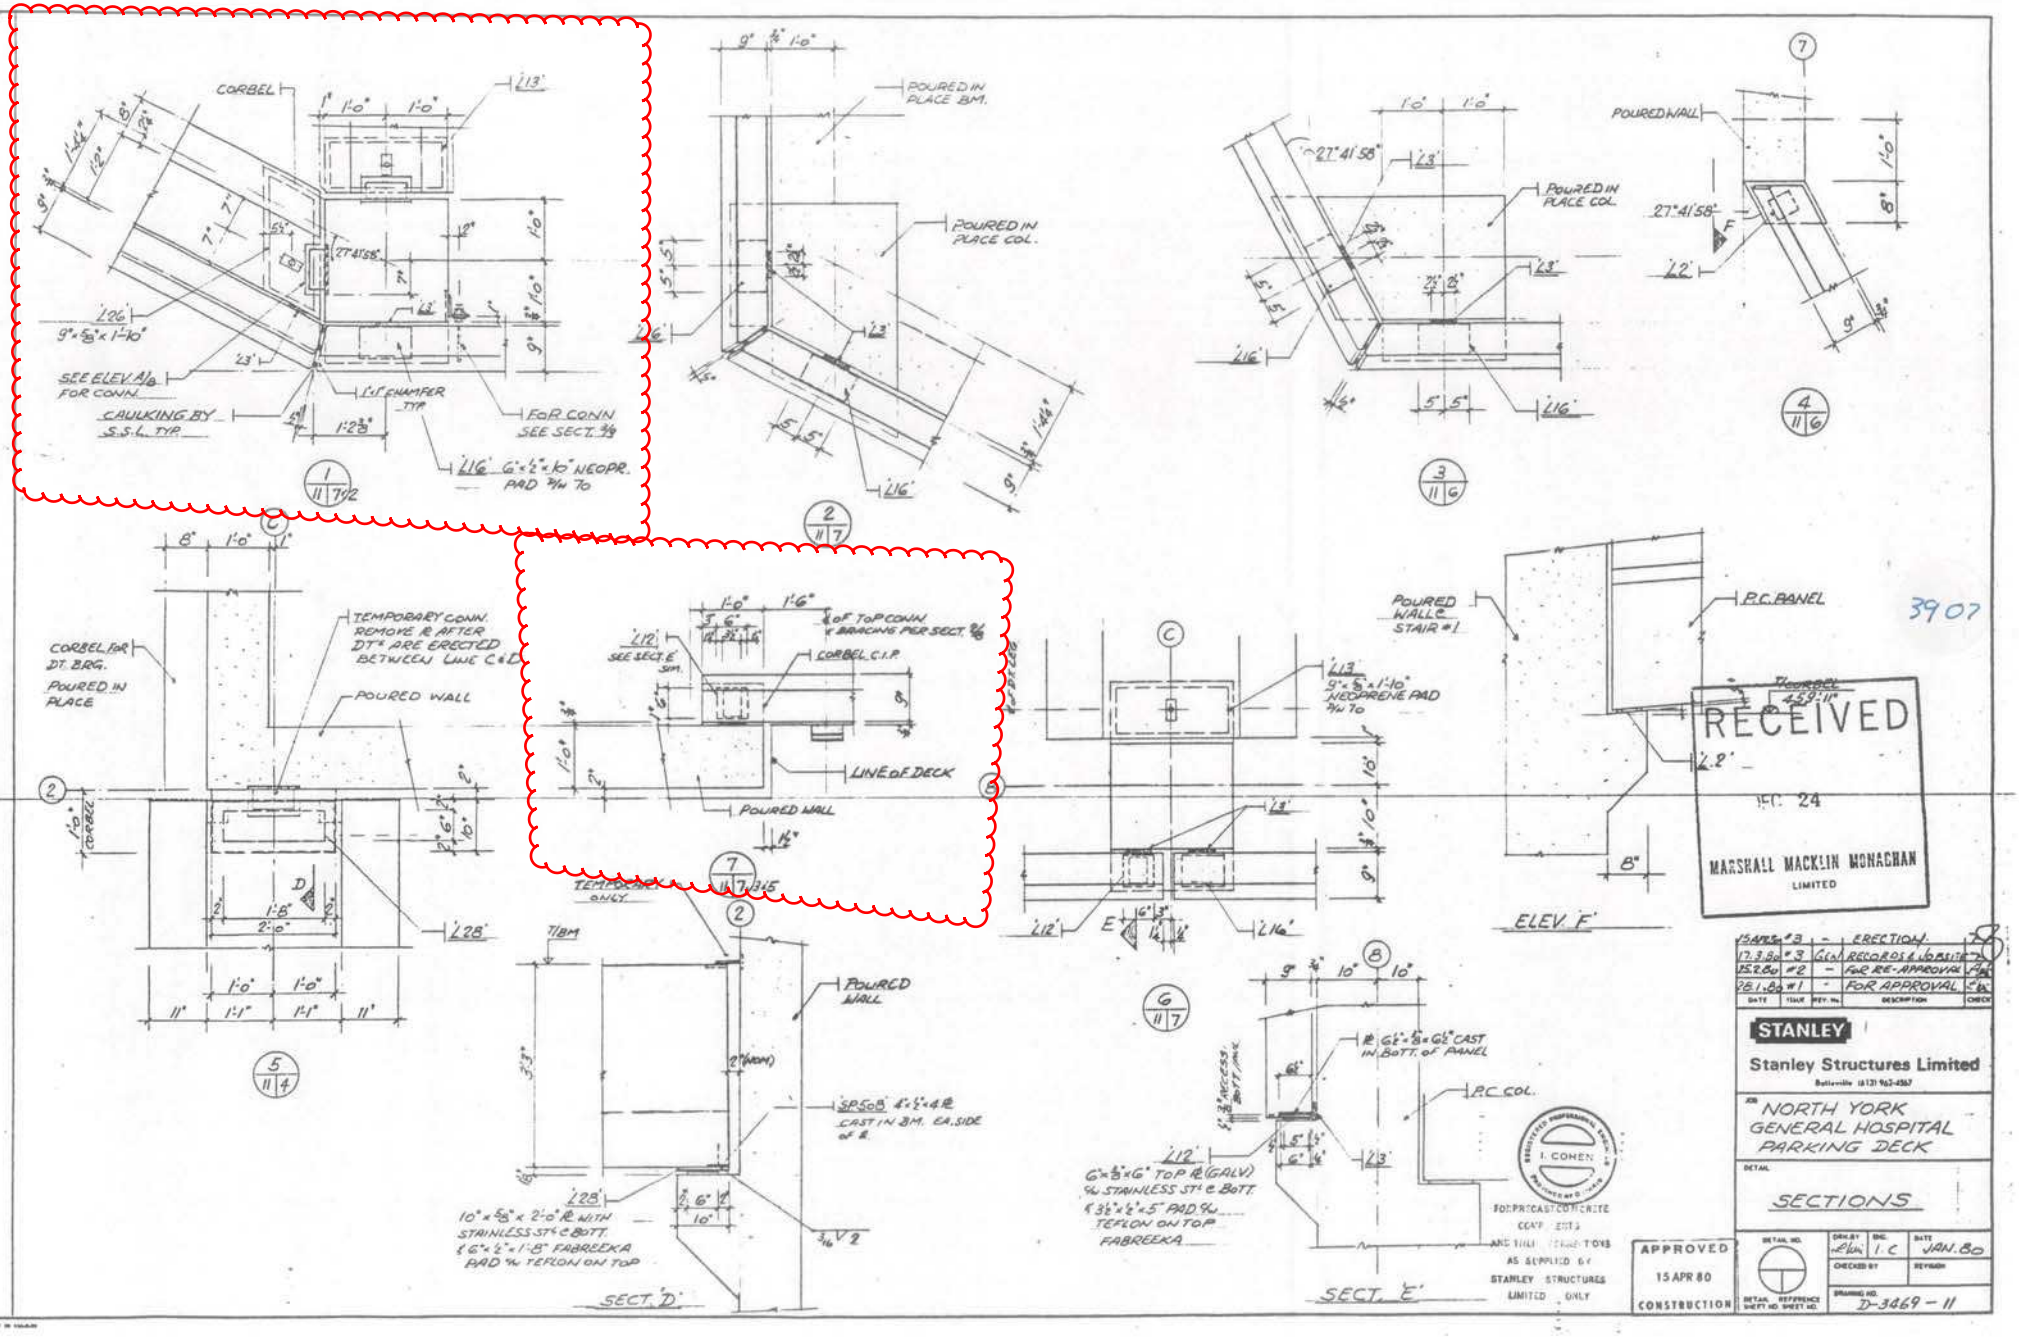
CORBEL
SEE ELEV A/6 FOR CONN.
CAULKING BY S.S.L. TYP.
1:1 CHAMFER TYP.
FOR CONN SEE SECT. 9/6
POURED IN PLACE BM.
POURED IN PLACE COL.
POURED WALL
POURED IN PLACE COL.
POURED WALL STAIR #1
P.C. PANEL
RECEIVED
MARSHALL MACKLIN MONAGHAN LIMITED
TEMPORARY CONN. REMOVE & AFTER DT'S ARE ERECTED BETWEEN LINE C & D
CORBEL FOR DT. BRG. POURED IN PLACE
POURED WALL
CORBEL C.I.P.
LINE OF DECK
TEMP. BLOCK ONLY
POURED WALL
SP508 4"x4"x4 lb. CAST IN BM. EA. SIDE OF 2
SECT. 'D'
P.C. COL.
SECT. 'E'
ELEV. 'F'
APPROVED
15 APR 80
CONSTRUCTION
STANLEY
Stanley Structures Limited
NORTH YORK GENERAL HOSPITAL PARKING DECK
SECTIONS
D-3469-11
3907

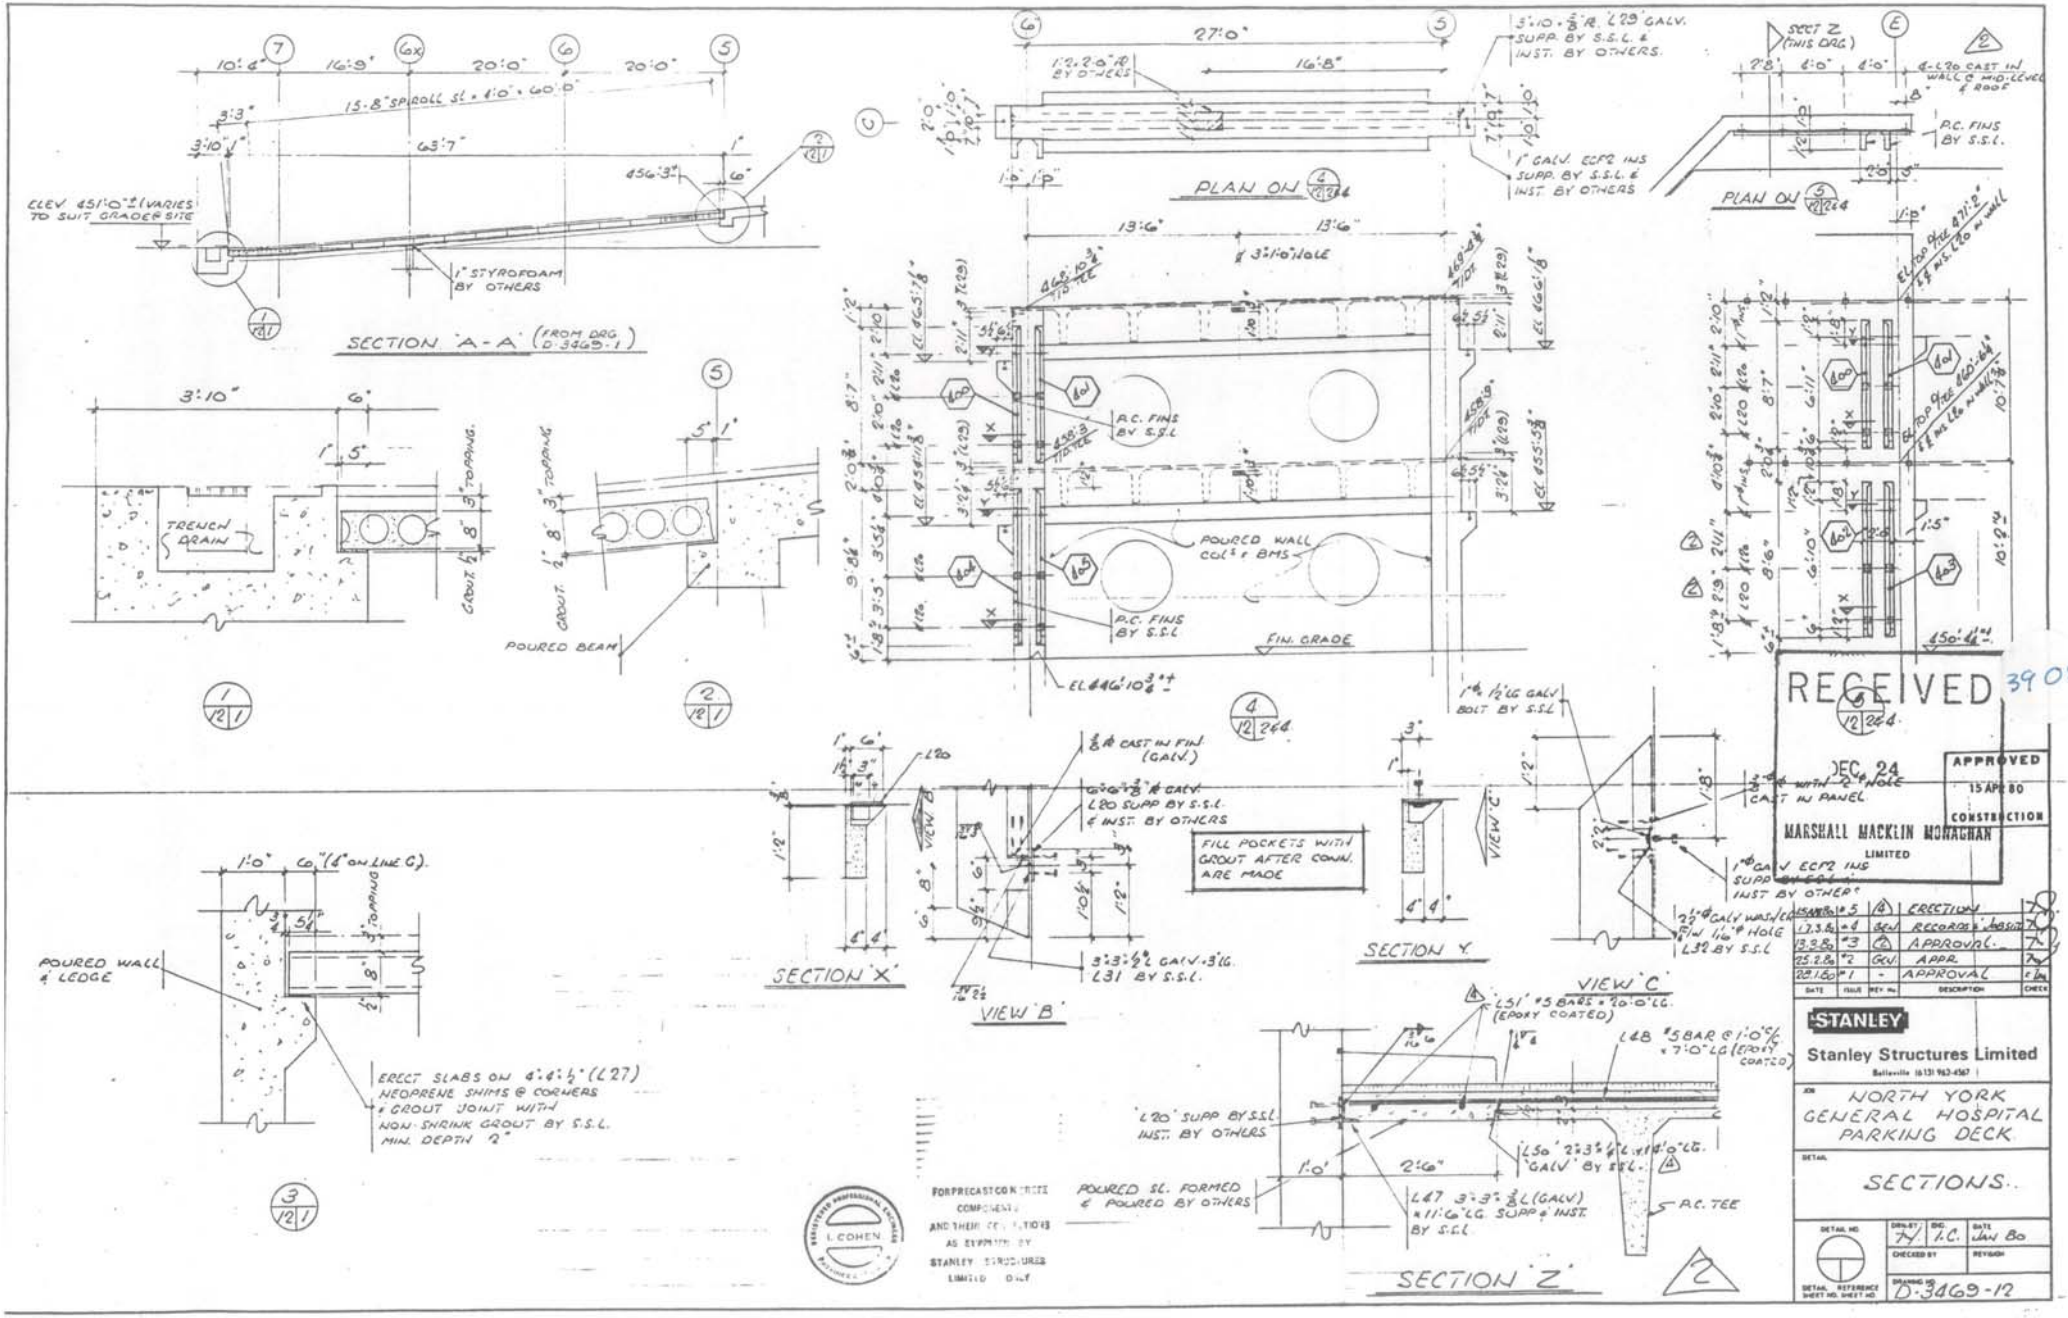
SECTION 'A-A' (FROM DRG. D-3469-1)
PLAN ON
SECT Z (THIS DRG.)
PLAN ON
SECTION 'X'
VIEW 'B'
SECTION 'Y'
VIEW 'C'
SECTION 'Z'
TRENCH DRAIN
POURED BEAM
POURED WALL & LEDGE
FILL POCKETS WITH GROUT AFTER CONN. ARE MADE
ERECT SLABS ON 4-6-½" (L27) NEOPRENE SHIMS @ CORNERS & GROUT JOINT WITH NON-SHRINK GROUT BY S.S.L. MIN. DEPTH 2"
FOR PRECAST CONCRETE COMPONENTS AND THEIR CONNECTIONS AS SUPPLIED BY STANLEY STRUCTURES LIMITED ONLY
I. COHEN
RECEIVED
DEC 24
APPROVED
15 APR 80
CONSTRUCTION
MARSHALL MACKLIN MONAGHAN LIMITED
STANLEY
Stanley Structures Limited
Belleville (613) 962-4567
NORTH YORK GENERAL HOSPITAL PARKING DECK
SECTIONS.
D-3469-12

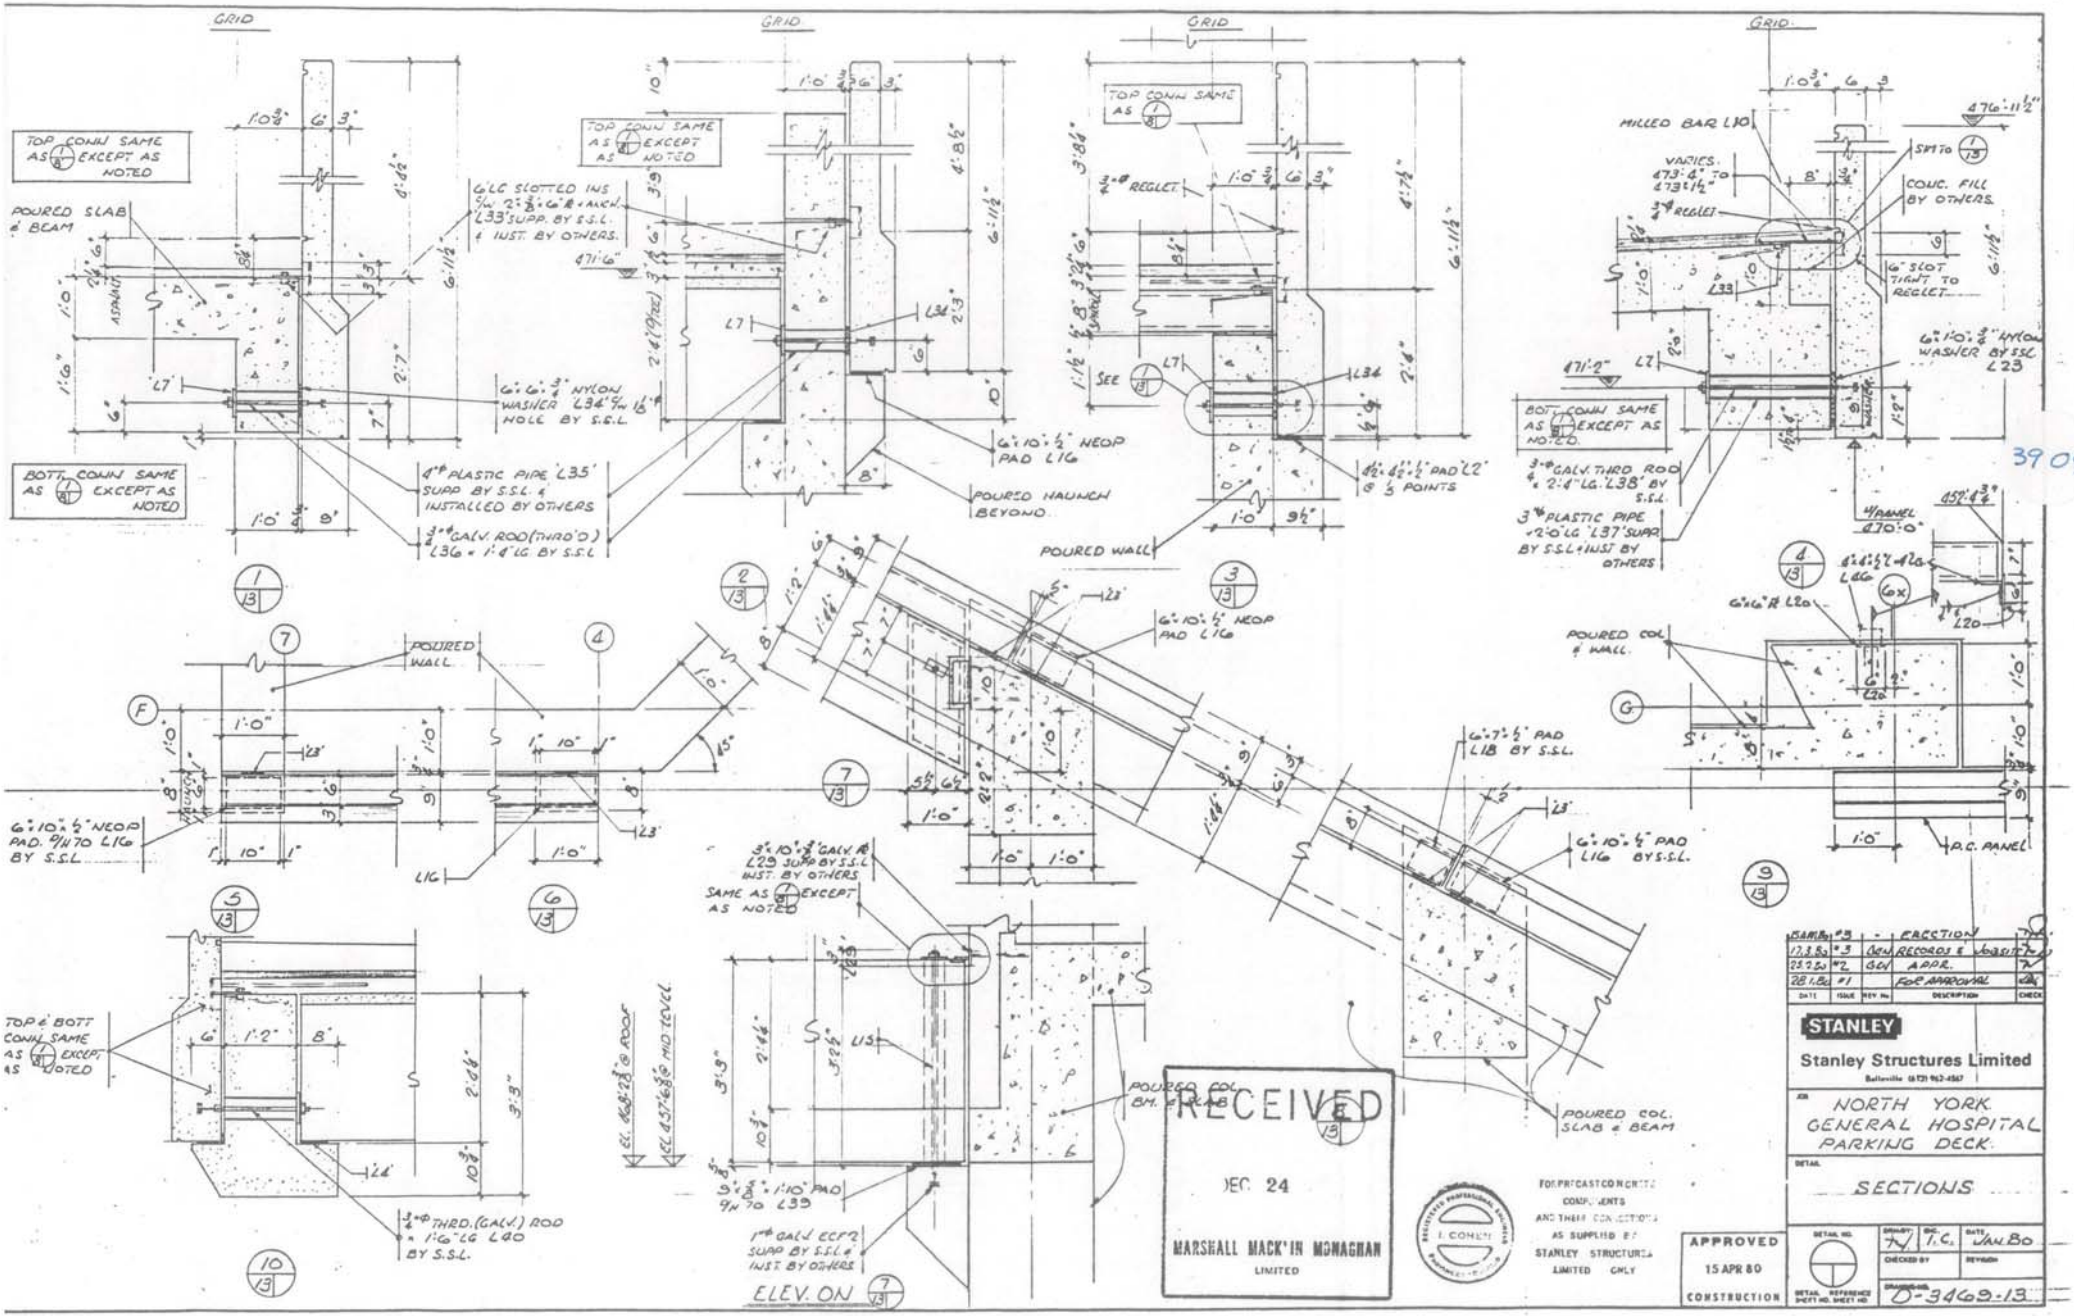
GRID
TOP CONN SAME AS 1/13 EXCEPT AS NOTED
POURED SLAB & BEAM
ASPHALT
BOTT. CONN SAME AS 1/13 EXCEPT AS NOTED
4" ϕ PLASTIC PIPE L35 SUPP. BY S.S.L. & INSTALLED BY OTHERS
3/4" ϕ GALV. ROD (THRD'D) L36 = 1'-4" LG. BY S.S.L.
6"LC SLOTTED INS 3/16" x 2" x 3/8" R x AS REQ'D L33 SUPP. BY S.S.L. & INST. BY OTHERS.
6" x 6" x 3/4" NYLON WASHER L34 7/16" HOLE BY S.S.L.
6" x 10" x 1/2" NEOP PAD L16
POURED HAUNCH BEYOND
TOP CONN SAME AS 1/13
3/4" ϕ REGLET
SEE 13/13
4 1/2" x 4 1/2" PAD L12 @ 1/3 POINTS
POURED WALL
MILLED BAR L10
VARIES 473'-4" TO 473'-11 1/2"
SEE 1/13
CONC. FILL BY OTHERS.
6" SLOT TIGHT TO REGLET
6" x 10" x 3/8" NYLON WASHER BY S.S.L. L23
BOTT. CONN SAME AS 1/13 EXCEPT AS NOTED.
3/4" ϕ GALV. THRD ROD x 2'-4" LG. L38 BY S.S.L.
3" PLASTIC PIPE x 2'-0" LG. L37 SUPP. BY S.S.L. & INST. BY OTHERS
4 PANEL @ 70'-0"
4 PRE-CAST PANEL
6" x 6" R L20
POURED COL. & WALL
6" x 10" x 1/2" NEOP PAD. 9/16 70 L16 BY S.S.L.
6" x 7" x 1/2" PAD L18 BY S.S.L.
6" x 10" x 1/2" PAD L16 BY S.S.L.
POURED COL. SLAB & BEAM
TOP & BOTT CONN SAME AS 1/13 EXCEPT AS NOTED
3/4" ϕ THRD. (GALV.) ROD x 1'-6" LG L40 BY S.S.L.
3" x 10" x 3/8" GALV. R L29 SUPP BY S.S.L. INST. BY OTHERS
SAME AS 1/13 EXCEPT AS NOTED
9/16" x 10" PAD 9/16 70 L39
1" GALV ECCP2 SUPP BY S.S.L. & INST BY OTHERS
ELEV. ON 7/13
POURED COL. SLAB & BEAM
RECEIVED
DEC 24
MARSHALL MACKLIN MONAGHAN LIMITED
FOR PRECAST CONCRETE COMPONENTS AND THEIR CONNECTIONS AS SUPPLIED BY STANLEY STRUCTURES LIMITED ONLY
I. COHEN
APPROVED
15 APR 80
CONSTRUCTION
STANLEY
Stanley Structures Limited
Belleville (613) 962-4567
NORTH YORK GENERAL HOSPITAL PARKING DECK
SECTIONS
DRAWN T.C.
CHECKED BY
DATE JAN. 80
REVISION
DRAWING NO. 0-3469-13
REVISIONS
12.2.80 #3 GEN RECORDS & ERECTION
23.2.80 #2 GEN APPR.
28.1.80 #1 FOR APPROVAL
DATE ISSUE REV No. DESCRIPTION CHECK

3909

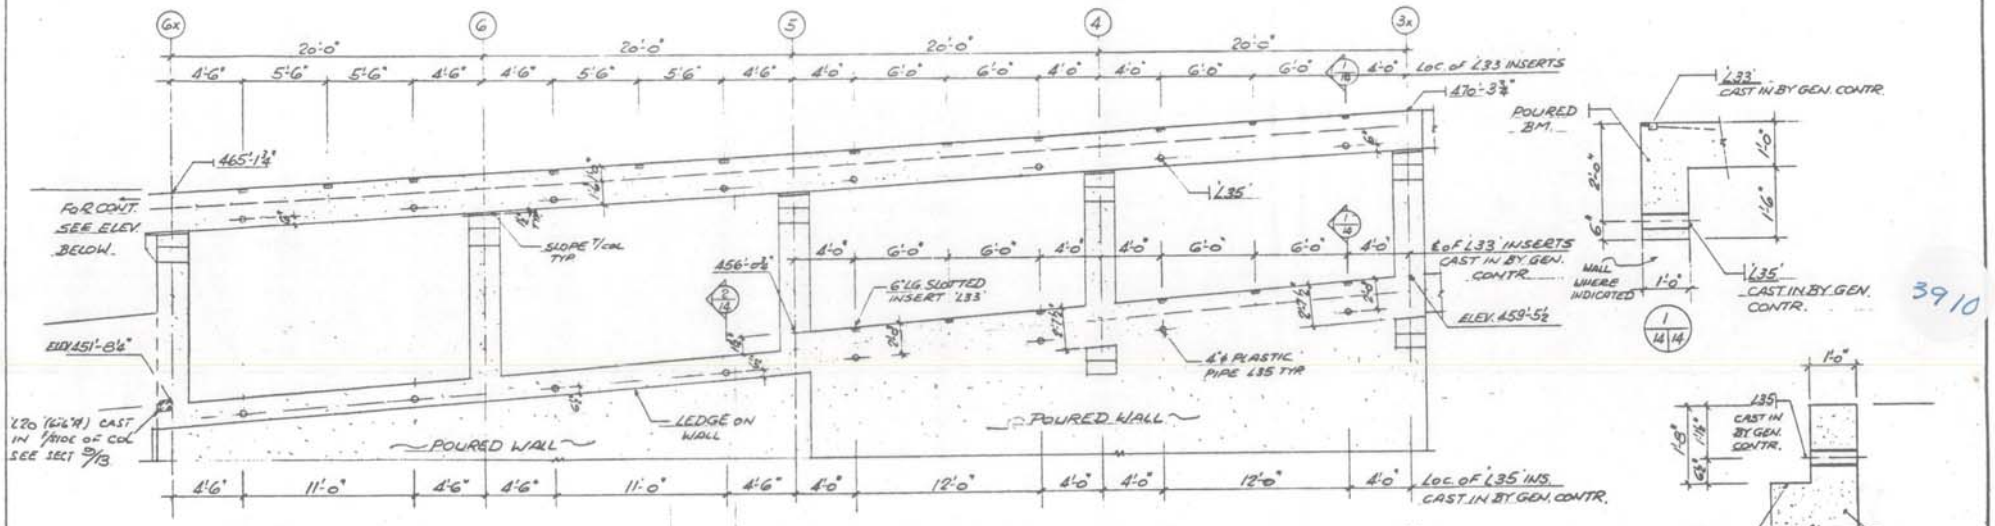

3910

RECEIVED
DEC 24
MARSHALL MACKLIN MONAGHAN LIMITED

1548.80	#2	-	ERECTION
1738	#2	Gen	RECORDS & ARCHIVE
252-54	#1	-	FOR APPROVAL
DATE	ISSUE	REV. No.	DESCRIPTION

I. COHEN

FOR PRECAST CONCRETE COMPONENTS AND THEIR CONNECTIONS AS SUPPLIED BY STANLEY STRUCTURES LIMITED ONLY

APPROVED
15 APR 80
CONSTRUCTION

STANLEY
Stanley Structures Limited
Belleville (613) 962-4567

JOB: NORTH YORK GENERAL HOSPITAL PARKING DECK

DETAIL: LAYOUT OF CAST-IN PLACE INSERTS

DRN. BY: JBC | CHG.: I.C. | DATE: FEB 80
CHECKED BY | REVISION

DETAIL NO. | DETAIL REFERENCE SHEET NO. | SHEET NO.

DRAWING NO. D-3469-14

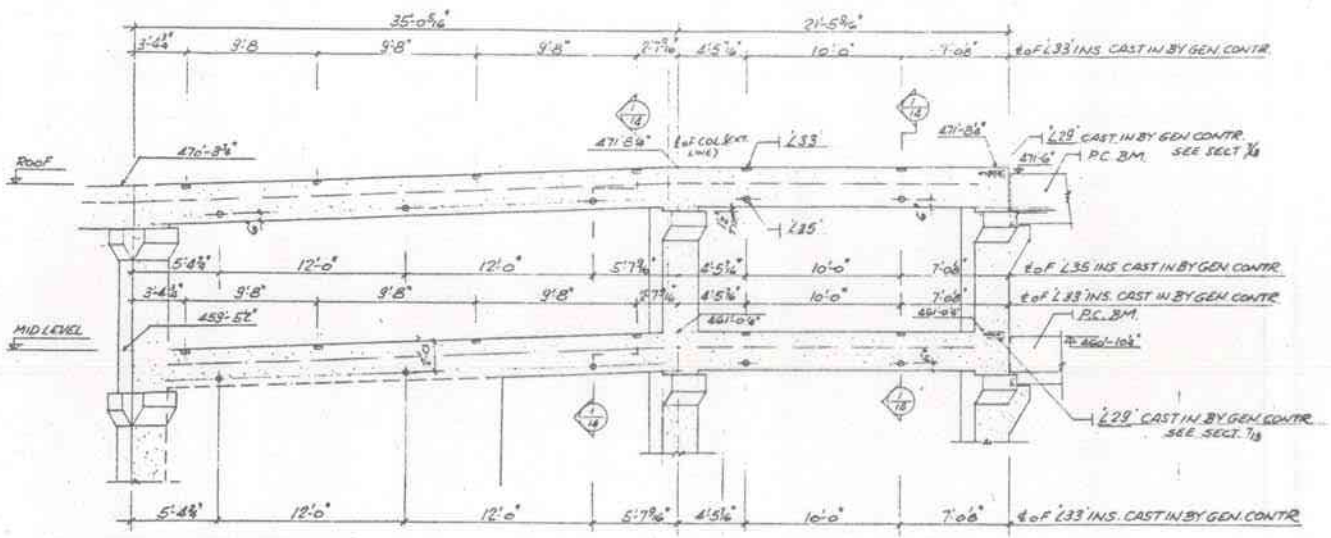

PART SOUTH ELEVATION

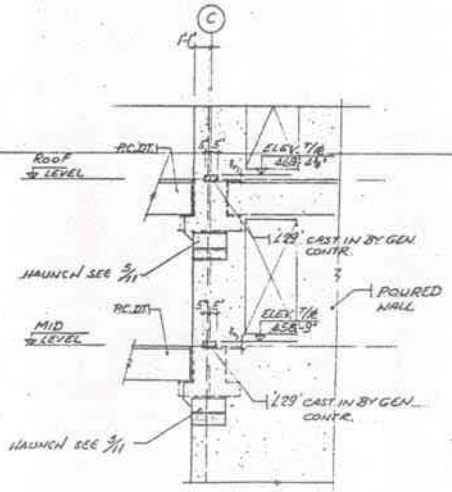

ELEVATION (STAIR #2 ALONG LINE 2)

3911

RECEIVED
DEC 24
MARSHALL MACKLIN MONAGHAN
LIMITED

PORPRECAST CONCRETE COMPONENTS AND THEIR CONNECTIONS AS SUPPLIED BY STANLEY STRUCTURES LIMITED ONLY

I. COHEN

APPROVED
15 APR 80
CONSTRUCTION

DATE	ISSUE	REV. No.	DESCRIPTION	CHECK
15 Apr 80	#2	-	ERECTION	
17 Mar 80	#2	Gen.	FOR RELEASE & ERECTION	
25 Feb 80	#1	-	FOR APPROVAL	IEC

STANLEY
Stanley Structures Limited
Belleville (613) 962-4567

JOB: NORTH YORK GENERAL HOSPITAL PARKING DECK

DETAIL: LAYOUT OF CAST-IN PLACE INSERTS

DRAWN BY: EAK | DES. I.C. | DATE: FEB. 1980
CHECKED BY | REVISED
DETAIL NO. | DETAIL REFERENCE SHEET NO. SHEET NO.
DRAWING NO. D-3469-15

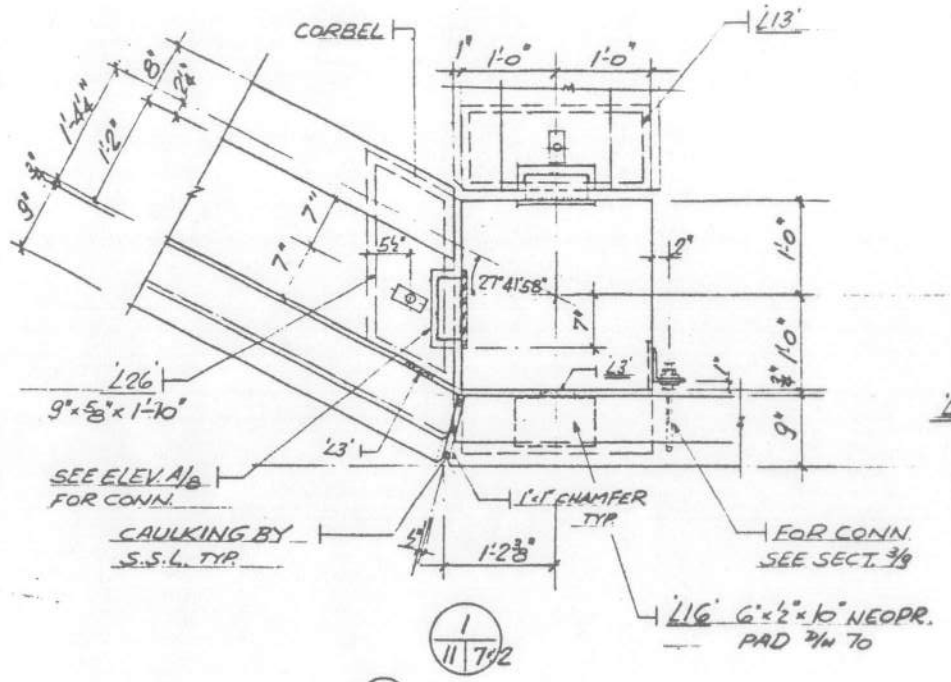

1/11/7½

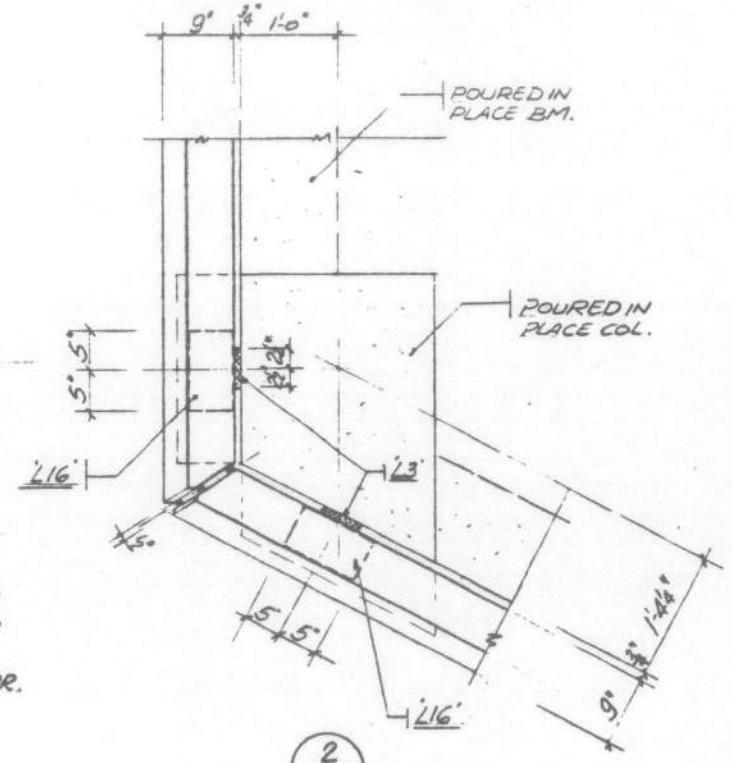

2/11/7

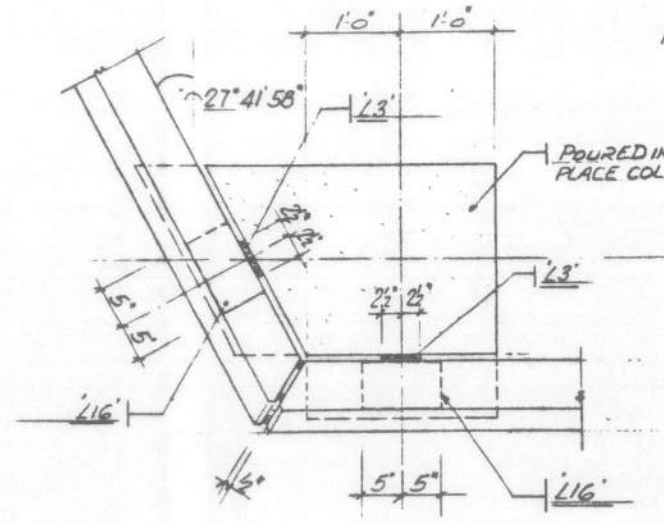

3/11/6

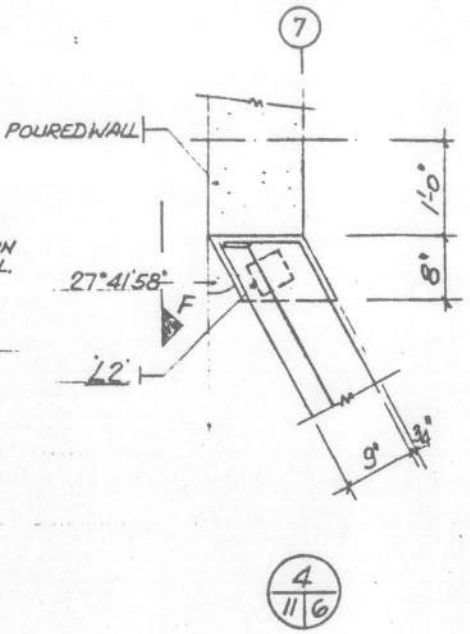

4/11/6

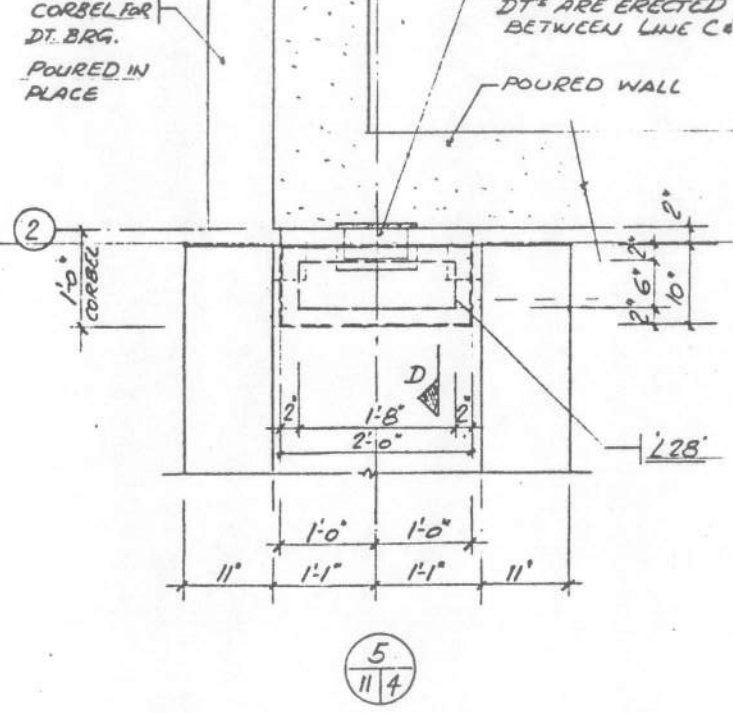

5/11/4

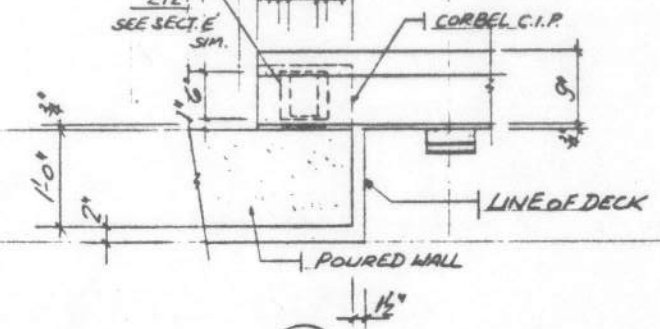

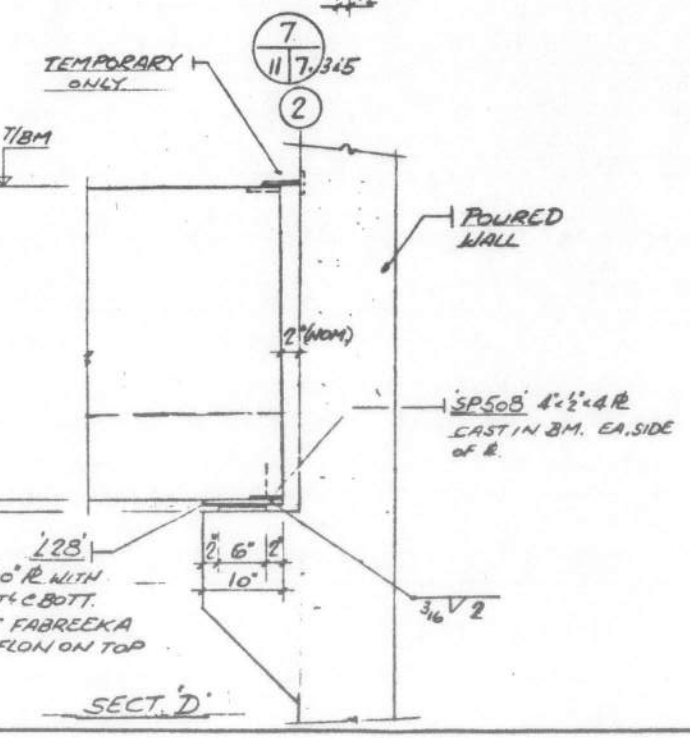

SECT. 'D'

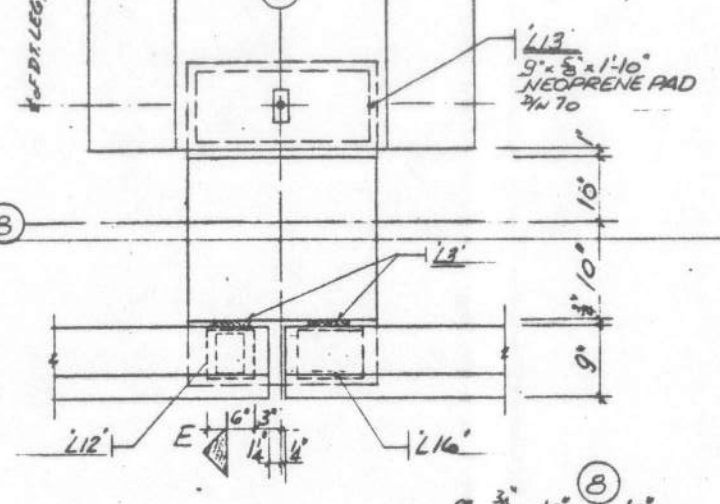

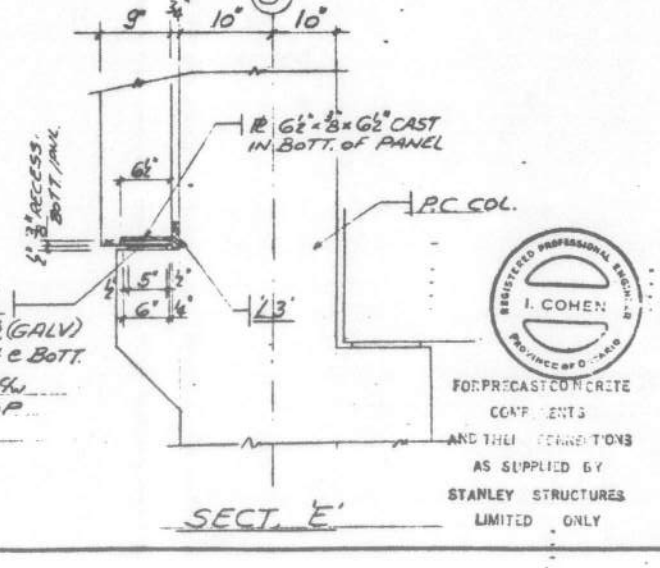

SECT. 'E'

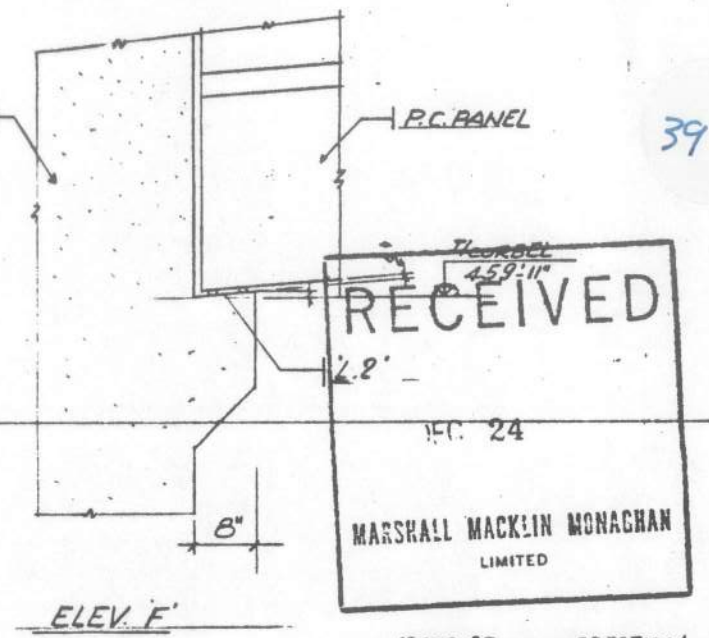

ELEV. 'F'

RECEIVED
FEB 24
MARSHALL MACKLIN MONAGHAN LIMITED

3907

DATE	ISSUE	REV. No.	DESCRIPTION	CHECK
15APR80	#3	–	ERECTION	
17.3.80	#3	GEM	RECORDS & JOBSITE	
25.2.80	#2	–	FOR RE-APPROVAL	
28.1.80	W1	–	FOR APPROVAL	

STANLEY

Stanley Structures Limited
Belleville (613) 962-4567

JOB NORTH YORK GENERAL HOSPITAL PARKING DECK

DETAIL SECTIONS

I. COHEN — REGISTERED PROFESSIONAL ENGINEER — PROVINCE OF ONTARIO

FOR PRECAST CONCRETE COMPONENTS AND THEIR CONNECTIONS AS SUPPLIED BY STANLEY STRUCTURES LIMITED ONLY

APPROVED
15 APR 80
CONSTRUCTION

DETAIL NO. — DETAIL REFERENCE SHEET NO. SHEET NO.

DRN. BY	ENG.	DATE
I.C	I.C	JAN. 80
CHECKED BY		REVISION
DRAWING NO. D-3469-11		

SECTION 'A-A' (FROM DRG. D-3469-1)

PLAN ON 4/12/2&4

PLAN ON 5/12/2&4

SECT Z (THIS DRG)

SECTION 'X'

VIEW 'B'

SECTION 'Y'

VIEW 'C'

SECTION 'Z'

TRENCH DRAIN

POURED BEAM

POURED WALL & LEDGE

ERECT SLABS ON 4"x4"x½" (L27) NEOPRENE SHIMS @ CORNERS & GROUT JOINT WITH NON-SHRINK GROUT BY S.S.L. MIN. DEPTH 2"

FILL POCKETS WITH GROUT AFTER CONN. ARE MADE

FOR PRECAST CONCRETE COMPONENTS AND THEIR CONNECTIONS AS SUPPLIED BY STANLEY STRUCTURES LIMITED ONLY

I. COHEN — REGISTERED PROFESSIONAL ENGINEER

RECEIVED 3908
12/2&4
DEC 24

APPROVED
15 APR 80
CONSTRUCTION
MARSHALL MACKLIN MONAGHAN LIMITED

DATE	ISSUE	REV No.	DESCRIPTION	CHECK
15APR80	#5	(4)	ERECTION	
17.3.80	#4	GCN	RECORDS ISSUE	
13.3.80	#3	(2)	APPROVAL	
25.2.80	#2	GCN	APPR.	
28.1.80	#1	-	APPROVAL	

STANLEY
Stanley Structures Limited
Belleville (613) 962-4567

JOB: NORTH YORK GENERAL HOSPITAL PARKING DECK

DETAIL: SECTIONS..

DETAIL NO.	DRN. BY	CHK.	DATE
DETAIL REFERENCE SHEET NO. SHEET NO.	M.	I.C.	JAN 80
	CHECKED BY		REVISION
	DRAWING NO. D-3469-12		

GRID

TOP CONN SAME AS 1/8 EXCEPT AS NOTED

POURED SLAB & BEAM

ASPHALT

L7

6"x6"x3/4" NYLON WASHER L34 c/w 1/8" HOLE BY S.S.L.

BOTT. CONN SAME AS 1/8 EXCEPT AS NOTED

4"ϕ PLASTIC PIPE L35 SUPP BY S.S.L. & INSTALLED BY OTHERS

3/4"ϕ GALV. ROD (THRD'D) L36 = 1'-8" LG. BY S.S.L

1/13

GRID

TOP CONN SAME AS 1/8 EXCEPT AS NOTED

6"LG SLOTTED INS c/w 2"x3/8"x6"R ANCH. L33 SUPP. BY S.S.L. & INST. BY OTHERS.

L7

L36

6"x10"x1/2" NEOP PAD L16

POURED HAUNCH BEYOND

2/13

GRID

TOP CONN SAME AS 1/8

3/4"ϕ REGLET

L7

SEE 1/13

L34

POURED WALL

4½"x4½"x½" PAD L22 @ ⅓ POINTS

3/13

GRID

MILLED BAR L10

VARIES. 473'-4" TO 473'-11½"

SIM TO 1/13

3/4"ϕ REGLET

CONC. FILL BY OTHERS

6" SLOT TIGHT TO REGLET

L33

6"x1'-0"x3/4" NYLON WASHER BY S.S.L. L23

L7

BOTT. CONN SAME AS 8/8 EXCEPT AS NOTED.

3/4"ϕ GALV. THRD ROD x 2'-4" LG. L38 BY S.S.L.

3"ϕ PLASTIC PIPE x 2'-0" LG. L37 SUPP BY S.S.L. & INST BY OTHERS

4/PANEL 470'-0"

4/13

4"x4"x½" ANG L46

6"x6"R L20

(6x)

L20

POURED COL & WALL

P.C. PANEL

9/13

7

POURED WALL

F

1'-0"

L23

6"x10"x½" NEOP PAD. 9/N 70 L16 BY S.S.L.

L16

4

1'-0"

45°

1'-0"

7/13

6"x7"x½" PAD L18 BY S.S.L.

6"x10"x½" PAD L16 BY S.S.L.

POURED COL. SLAB & BEAM

5/13

6/13

TOP & BOTT CONN SAME AS 7/8 EXCEPT AS NOTED

L24

3/4"ϕ THRD. (GALV.) ROD = 1'-6" LG L40 BY S.S.L.

10/13

3"x10"x⅜" GALV. PL L29 SUPP BY S.S.L INST. BY OTHERS

SAME AS 7/8 EXCEPT AS NOTED

L15

EL. 468'-2⅜" @ ROOF

EL. 457'-6⅝" @ MID LEVEL

POURED COL. SLAB & BEAM

8/13

5"x8"x⅝" PAD 9/N 70 L39

1"ϕ GALV ECCP SUPP BY S.S.L & INST BY OTHERS

ELEV. ON 7/13

RECEIVED

DEC 24

MARSHALL MACKLIN MONAGHAN LIMITED

J. COHEN REGISTERED PROFESSIONAL ENGINEER PROVINCE OF ONTARIO

FOR PRECAST CONCRETE COMPONENTS AND THEIR CONNECTIONS AS SUPPLIED BY STANLEY STRUCTURES LIMITED ONLY

APPROVED 15 APR 80 CONSTRUCTION

SAMBA	#	-	ERECTION
17.3.80	#3	GCH	RECORDS & ASBUILT
25.2.80	#2	GCH	APPR.
28.1.80	#1		FOR APPROVAL
DATE	ISSUE	REV. No.	DESCRIPTION

STANLEY

Stanley Structures Limited

Belleville (613) 962-4567

JOB NORTH YORK GENERAL HOSPITAL PARKING DECK

DETAIL SECTIONS

DETAIL NO. | DRAWN BY TV | CHK. T.C. | DATE JAN 80 | CHECKED BY | REVISION

DETAIL REFERENCE SHEET NO. SHEET NO.

DRAWING NO. 0-3409-13

3909

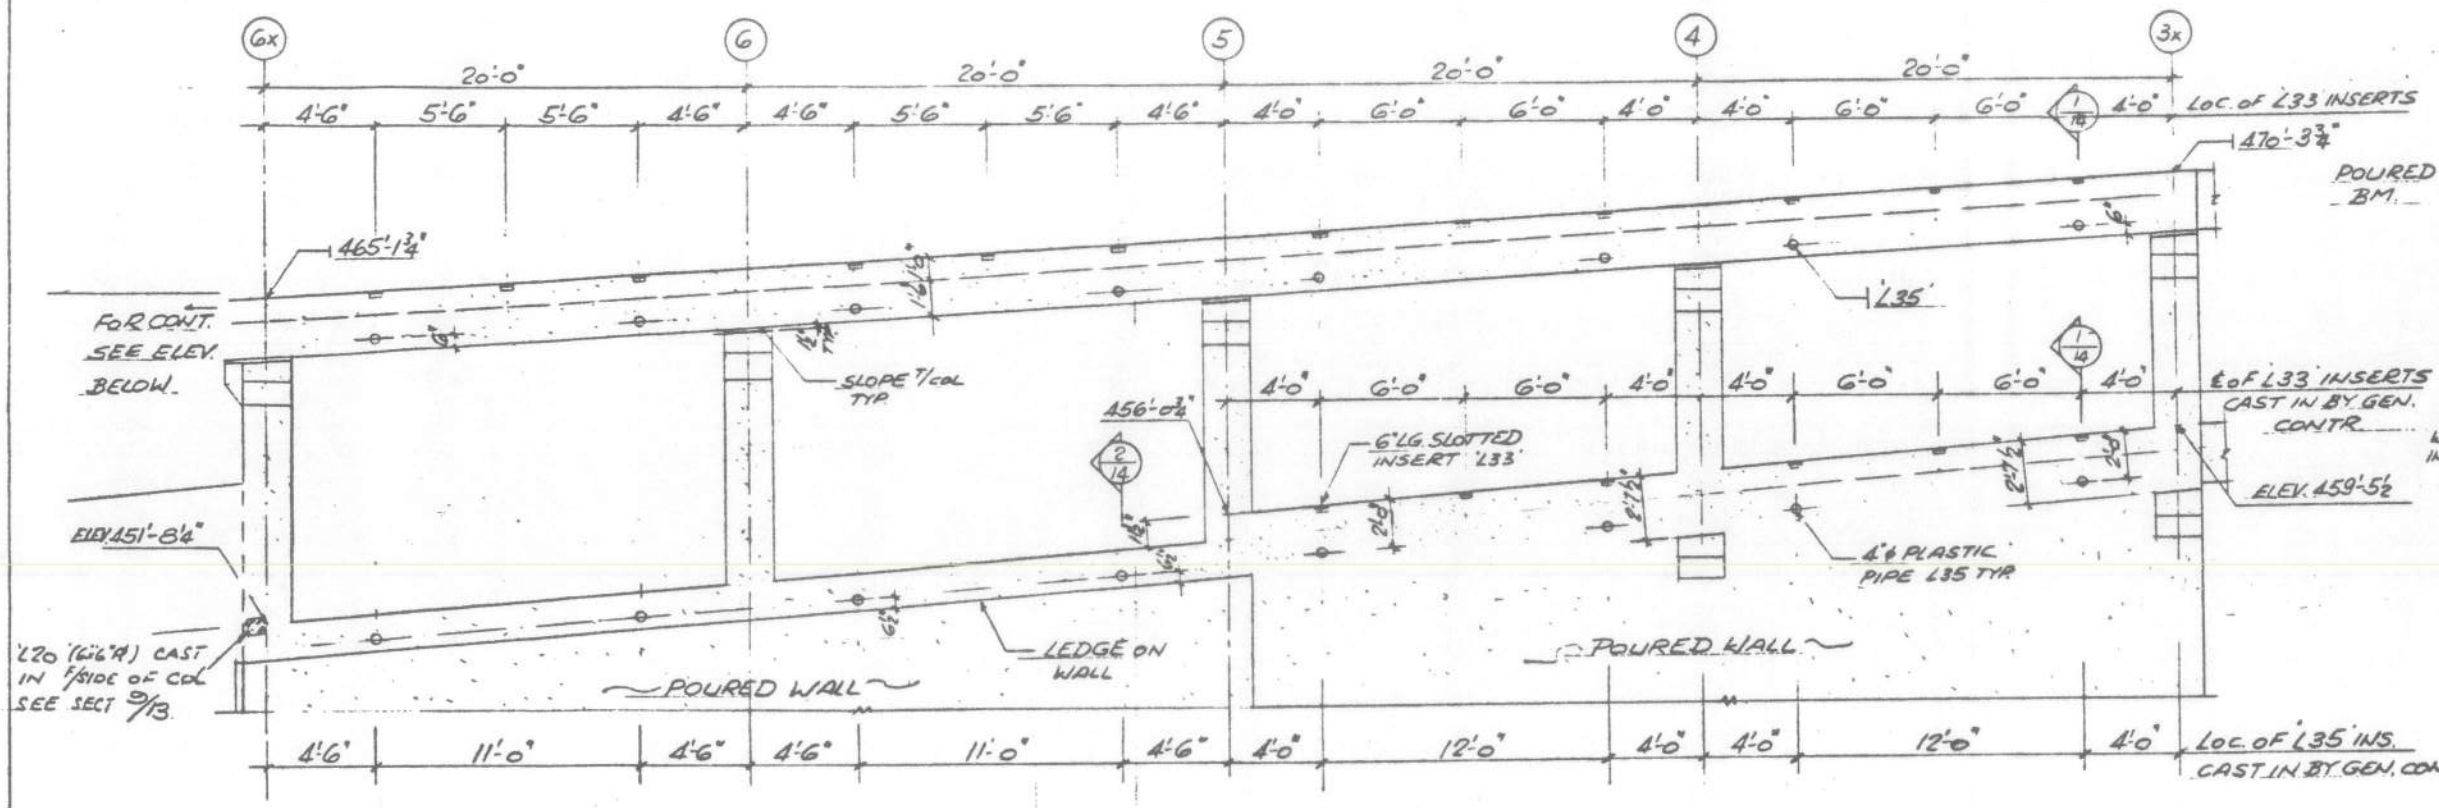

WEST ELEVATION
(RAMP)

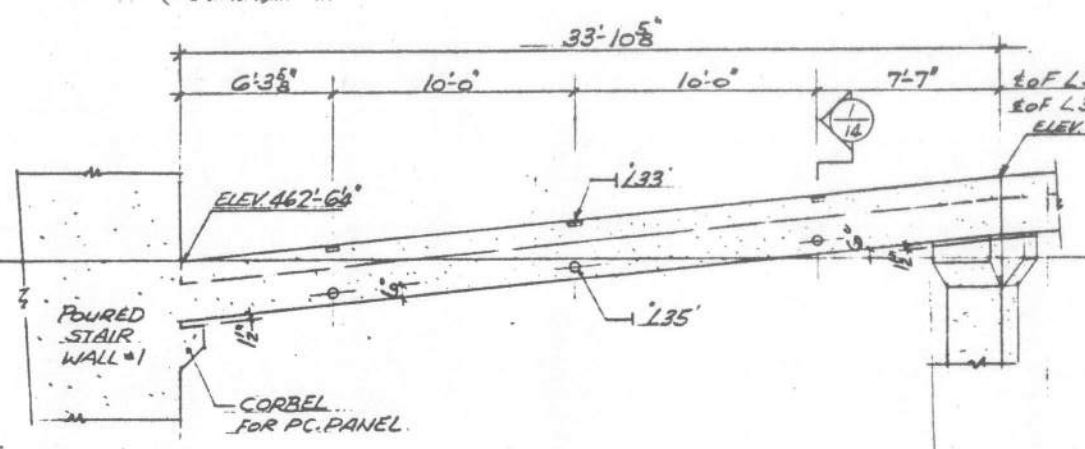

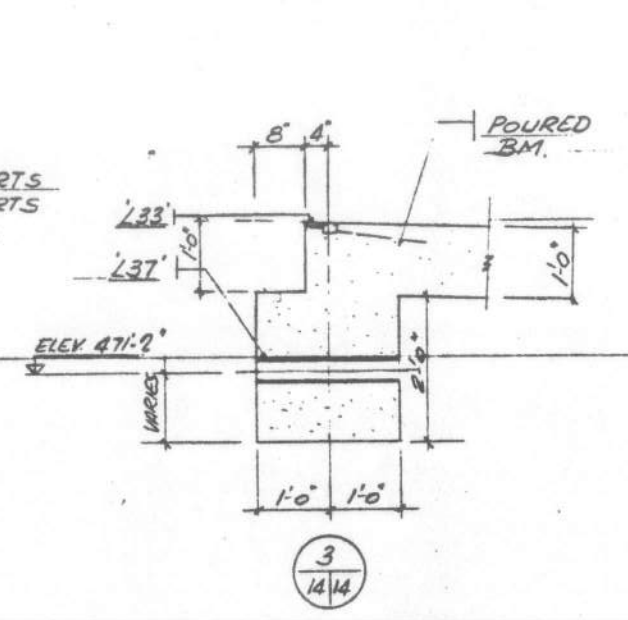

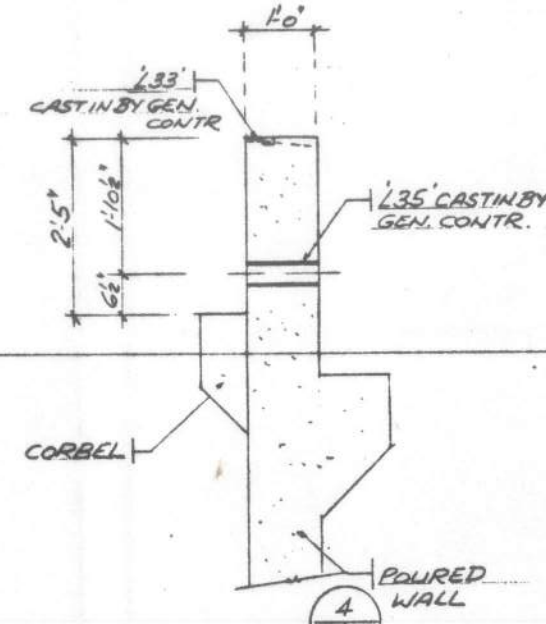

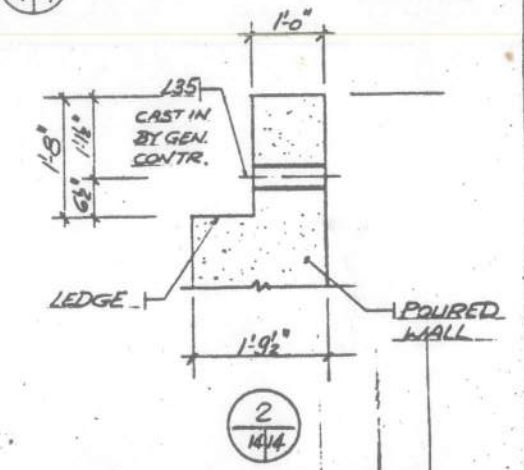

NORTH ELEVATION
(RAMP)

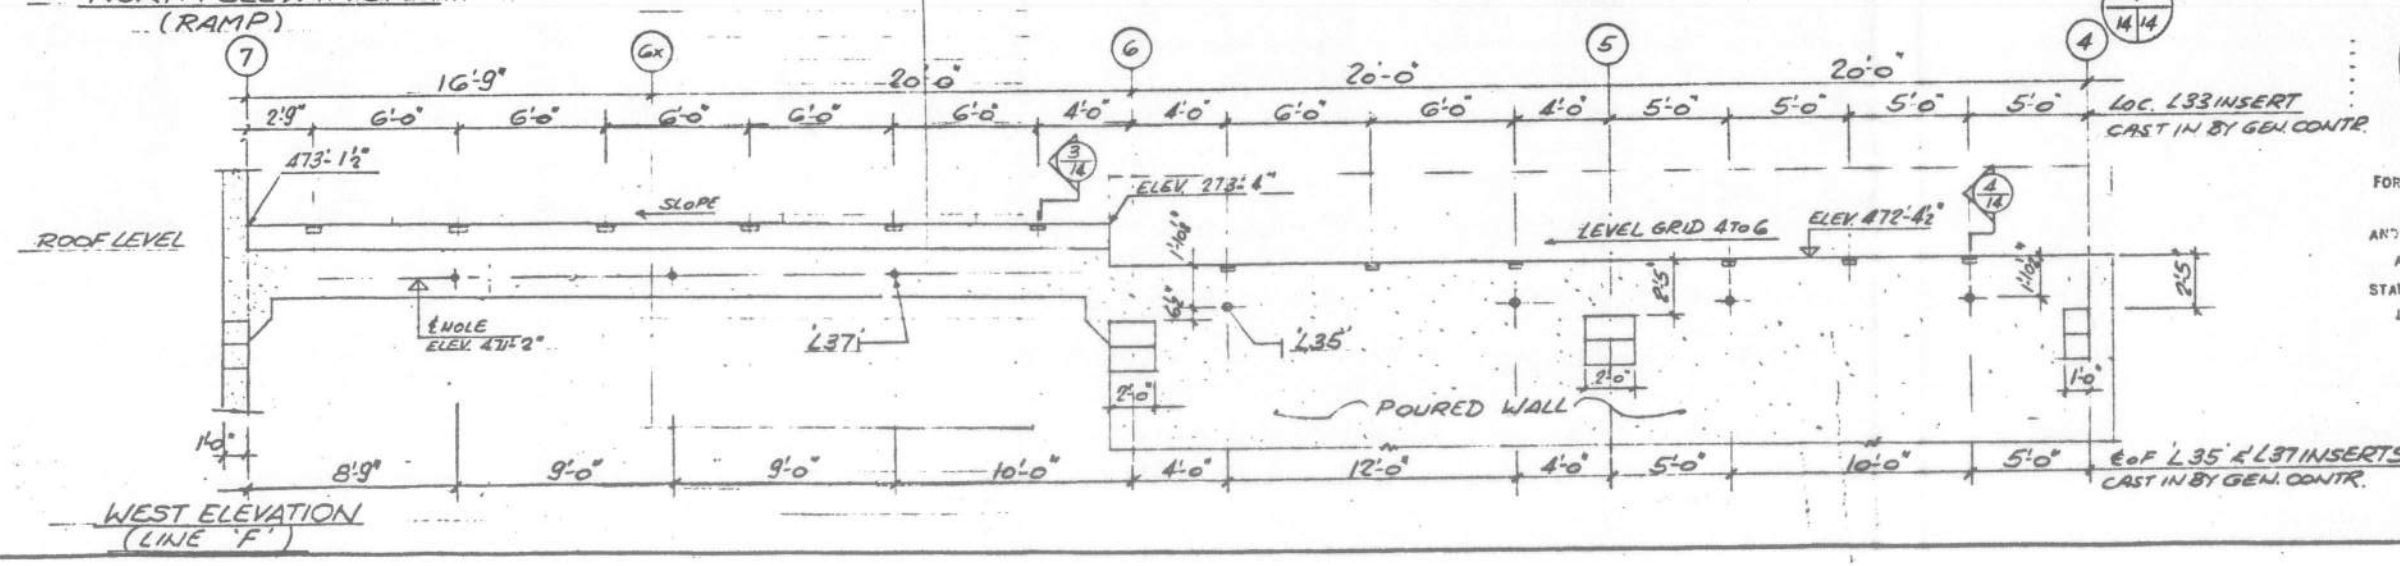

WEST ELEVATION
(LINE 'F')

FOR PRECAST CONCRETE COMPONENTS AND THEIR CONNECTIONS AS SUPPLIED BY STANLEY STRUCTURES LIMITED ONLY

I. COHEN
REGISTERED PROFESSIONAL ENGINEER
PROVINCE OF ONTARIO

APPROVED
15 APR 80
CONSTRUCTION

RECEIVED
DEC 24
MARSHALL MACKLIN MONAGHAN LIMITED

3910

DATE	ISSUE	REV. No.	DESCRIPTION	CHECK
15.11.80	#2	-	ERECTION	
17.3.80	#2	GEN	RECORDS & JOBSITE	
25.2.80	#1	-	FOR APPROVAL	

STANLEY
Stanley Structures Limited
Belleville (613) 962-4567

JOB: NORTH YORK GENERAL HOSPITAL PARKING DECK

DETAIL: LAYOUT OF CAST-IN PLACE INSERTS

DETAIL NO.	DRW. BY	ENG.	DATE
DETAIL REFERENCE SHEET NO. SHEET NO.	Fine	I.C.	FEB. 80
	CHECKED BY		REVISION
	DRAWING NO. D-3469-14		

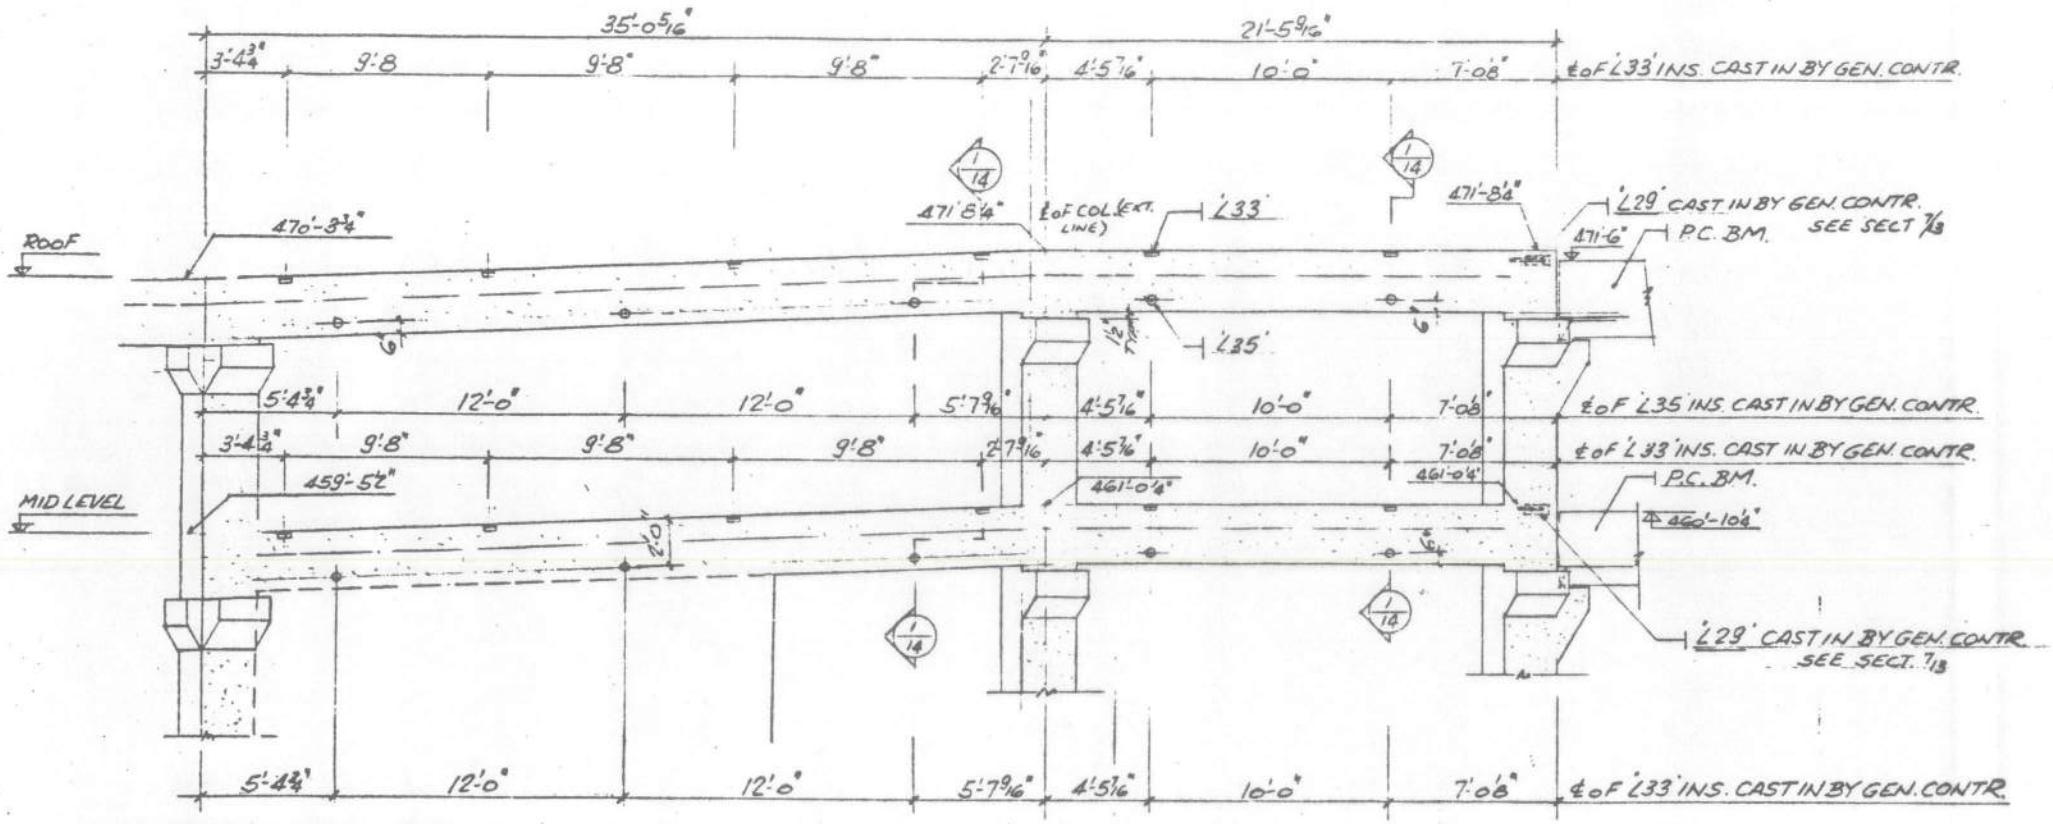

PART SOUTH ELEVATION

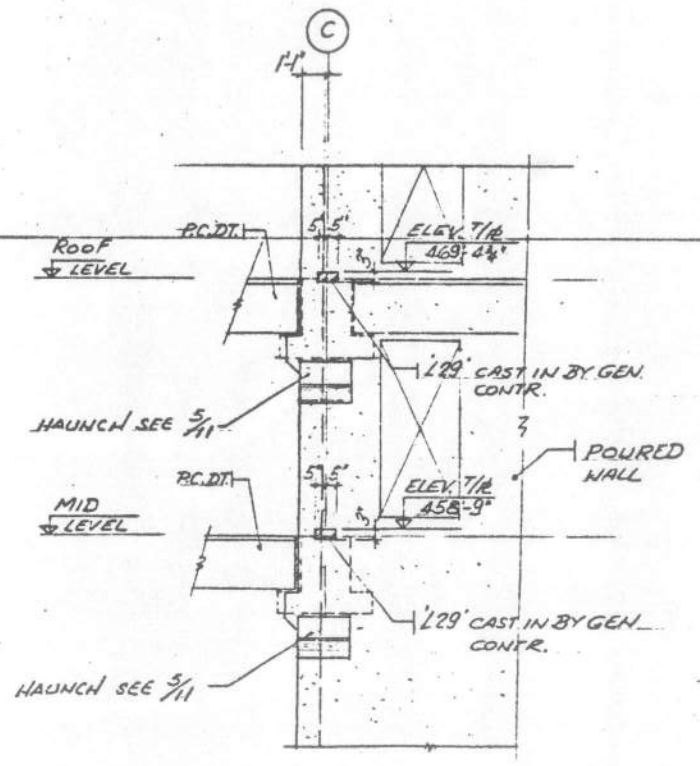

ELEVATION (STAIR #2 ALONG LINE 2

RECEIVED
DEC 24
MARSHALL MACKLIN MONAGHAN LIMITED

DATE	ISSUE	REV. No	DESCRIPTION	CHECK
15 APR 80	#2	-	ERECTION	
25.2.80	#1	-	FOR APPROVAL	

FOR PRECAST CONCRETE COMPONENTS AND THEIR CONNECTIONS AS SUPPLIED BY STANLEY STRUCTURES LIMITED ONLY

REGISTERED PROFESSIONAL ENGINEERS PROVINCE OF ONTARIO I. COHEN

APPROVED 15 APR 80 CONSTRUCTION

DETAIL NO. DETAIL REFERENCE SHEET NO. SHEET NO.

STANLEY.
Stanley Structures Limited
Belleville (613) 962-4567

JOB NORTH YORK GENERAL HOSPITAL PARKING DECK

DETAIL LAYOUT OF CAST-IN PLACE INSERTS

DRN. BY	ENG.	DATE
℄BK	I.C	FEB. 1980
CHECKED BY		REVISION

DRAWING NO. D-3469-15

3911

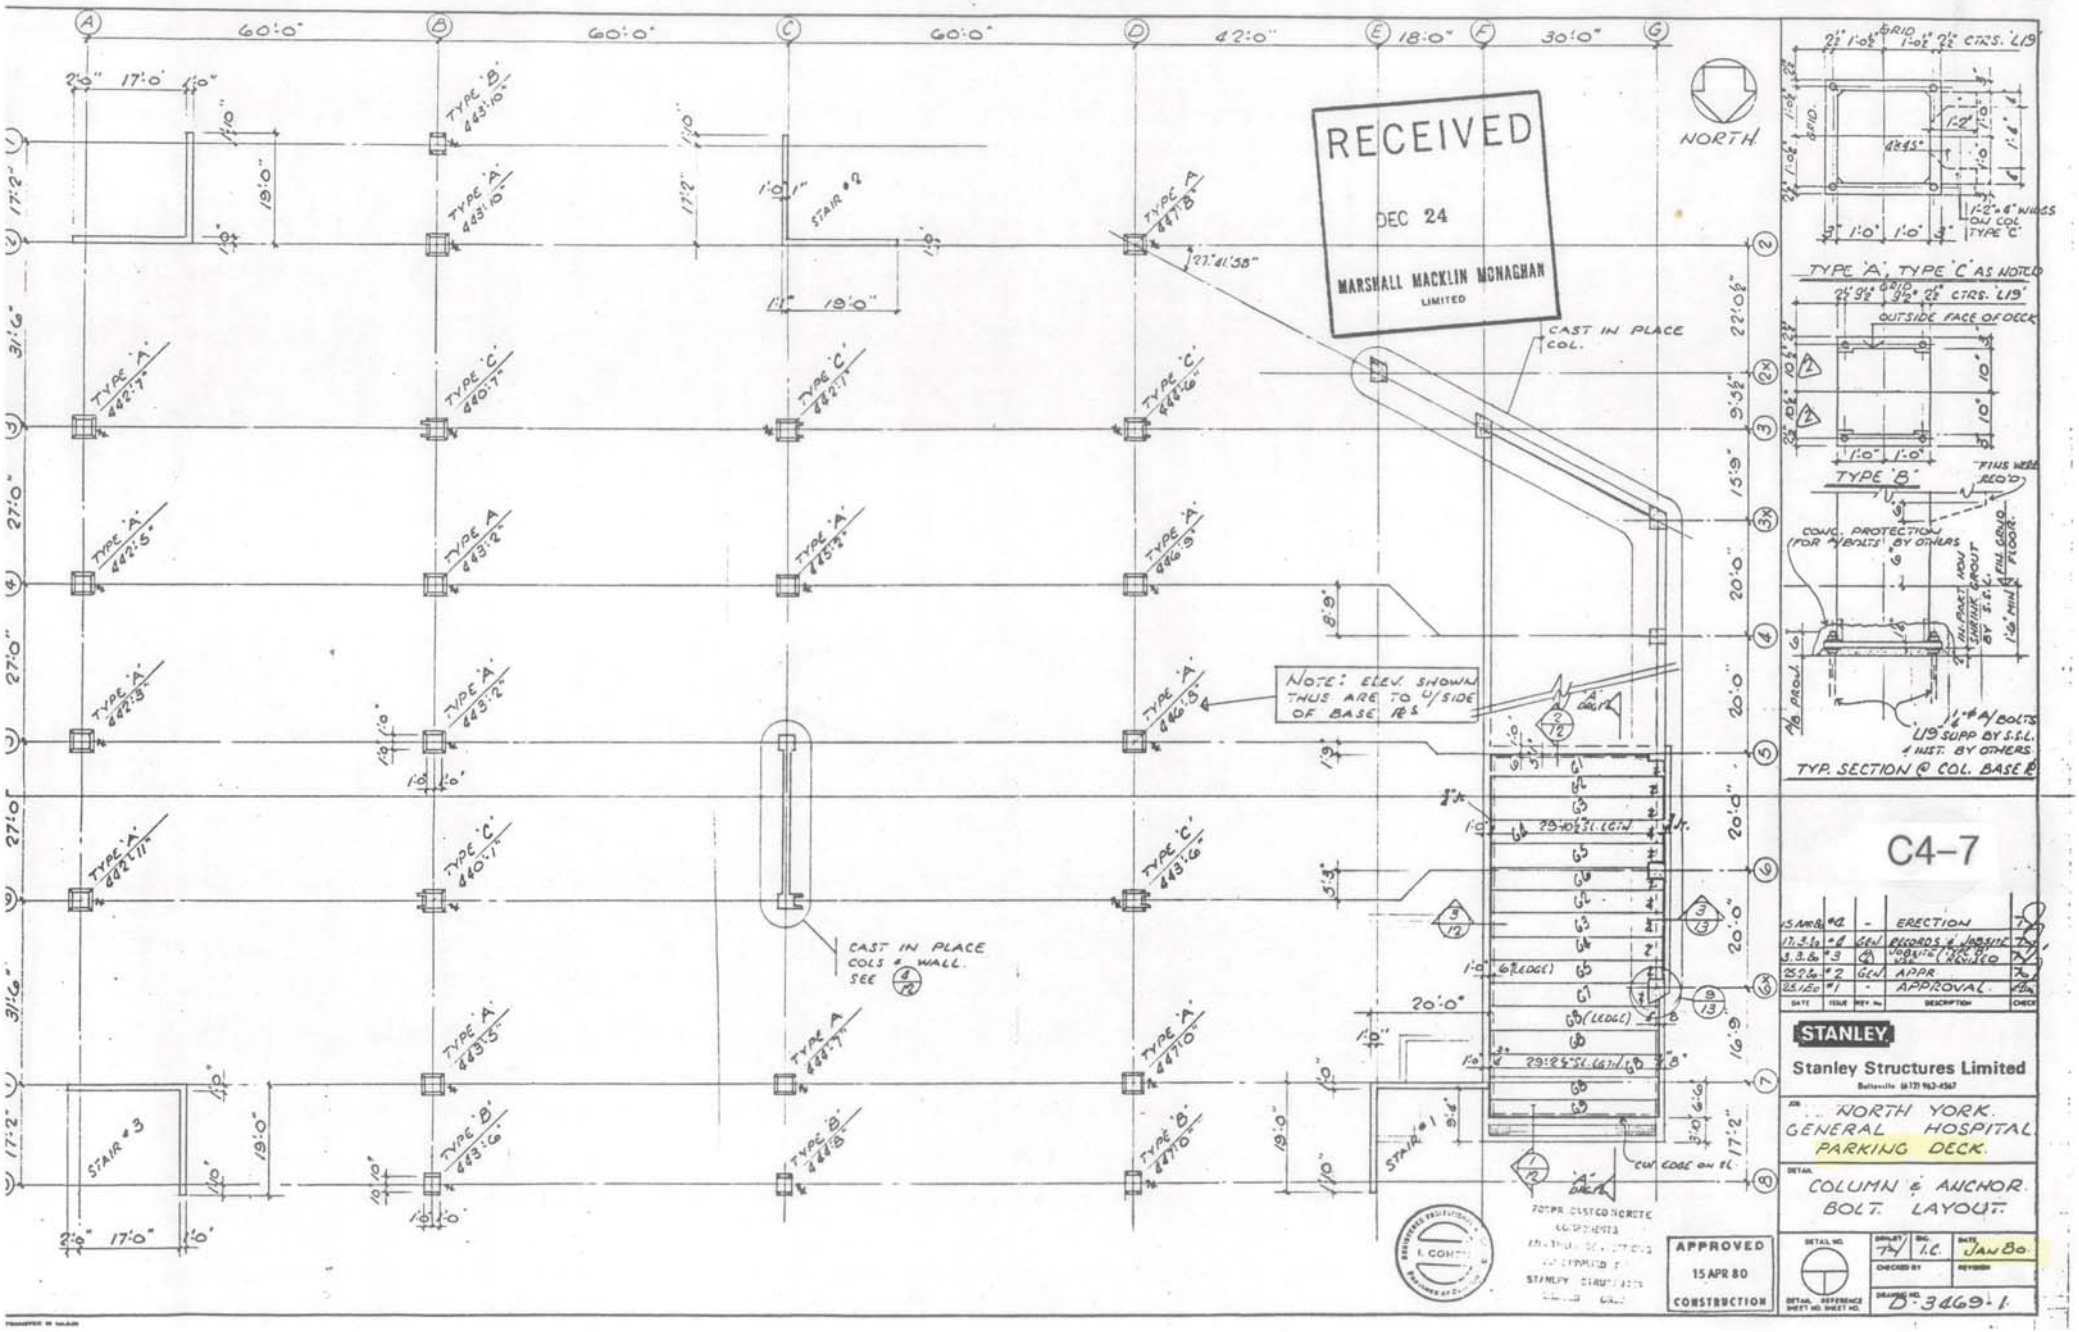

C4-7

15 APR 80	#2	-	ERECTION	
17.3.1a	#1	GEN	RECORDS @ JOBSITE	
5.3.6a	#3	GEN	JOBSITE (TYP. OF 2) REVISED	
25.2.6	#2	GEN	APPR	
25.1.2a	#1	-	APPROVAL	
DATE	ISSUE	REV. No	DESCRIPTION	CHECK

STANLEY

Stanley Structures Limited

Belleville (613) 962-4567

JOB: NORTH YORK GENERAL HOSPITAL PARKING DECK

DETAIL: COLUMN & ANCHOR BOLT LAYOUT

DETAIL NO. | DRAWN BY TH | ENG. I.C. | DATE JAN 80

DETAIL REFERENCE SHEET NO. SHEET NO. | CHECKED BY | REVISION

DRAWING NO. B-3469-1

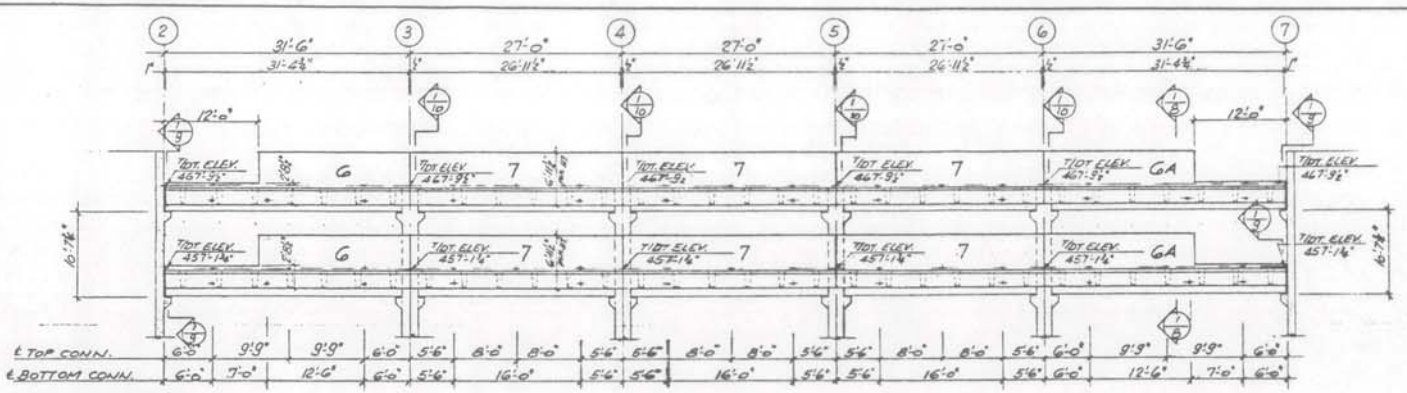

EAST ELEVATION
ALONG LINE 'A'

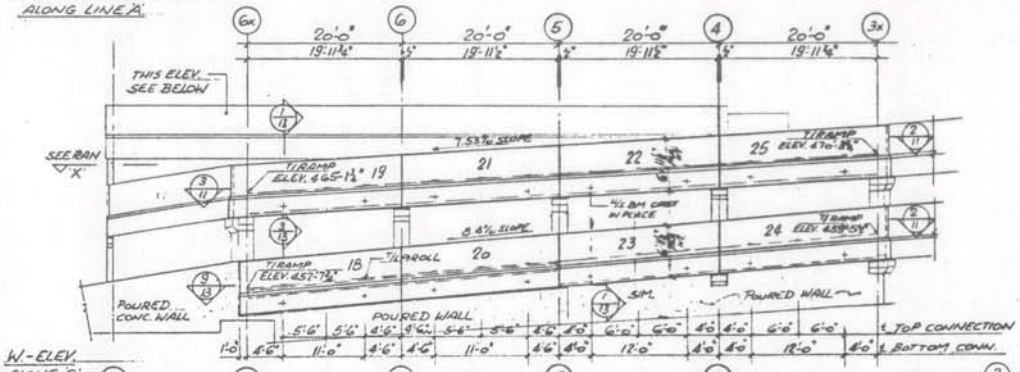

W-ELEV.
ALONG 'G'

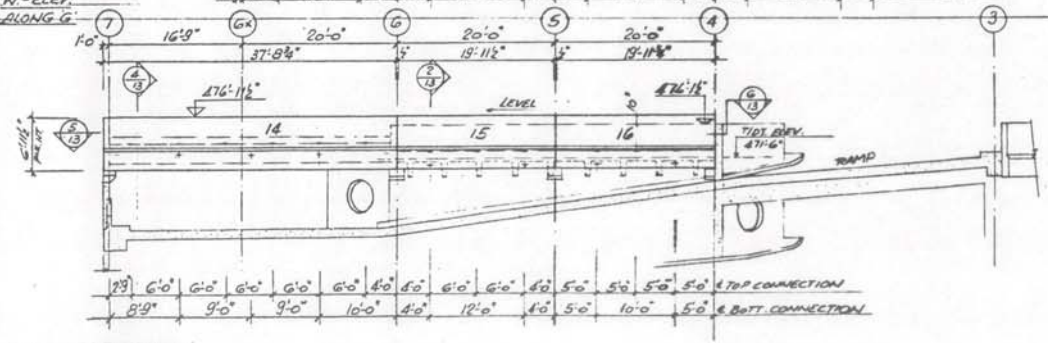

WEST ELEVATION
ALONG LINE 'F' & 'G'

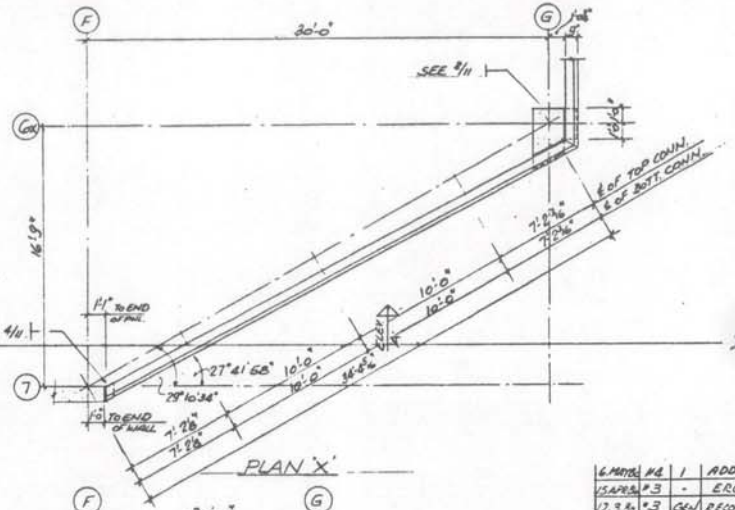

PLAN 'X'

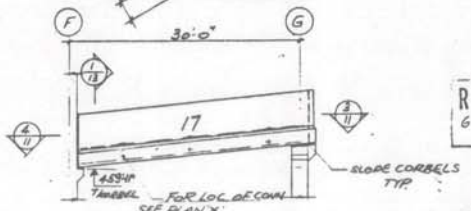

ELEVATION 'A'

FOR PRECAST CONCRETE COMPONENTS AND THEIR CONNECTIONS AS SUPPLIED BY STANLEY STRUCTURES LIMITED ONLY

RECEIVED
DEC 24
MARSHALL MACKLIN MONAGHAN
LIMITED

3902

REVISED
6 MAY 1980

APPROVED
15 APR 80
CONSTRUCTION

I. COHEN

DATE	ISSUE	REV. No.	DESCRIPTION	CHECK
6 MAY 80	#4	1	ADD MARK No's	
15 APR 80	#3	-	ERECTION	
17 MAR 80	#3	CA-1	RECORDS & JOBSITE	
25 FEB 80	#2	-	FOR RE-APPROVAL	
21 JAN 80	#1	-	FOR APPROVAL	

STANLEY
Stanley Structures Limited
Belleville (613) 962-4567

JOB
NORTH YORK GENERAL HOSPITAL PARKING DECK

DETAIL
PANEL ELEVATIONS

DETAIL NO.
DRN. BY I.C.
DES. I.C.
DATE JAN. 80
CHECKED BY
REVISION
DETAIL REFERENCE SHEET NO. SHEET NO.
DRAWING NO. D-3469-6

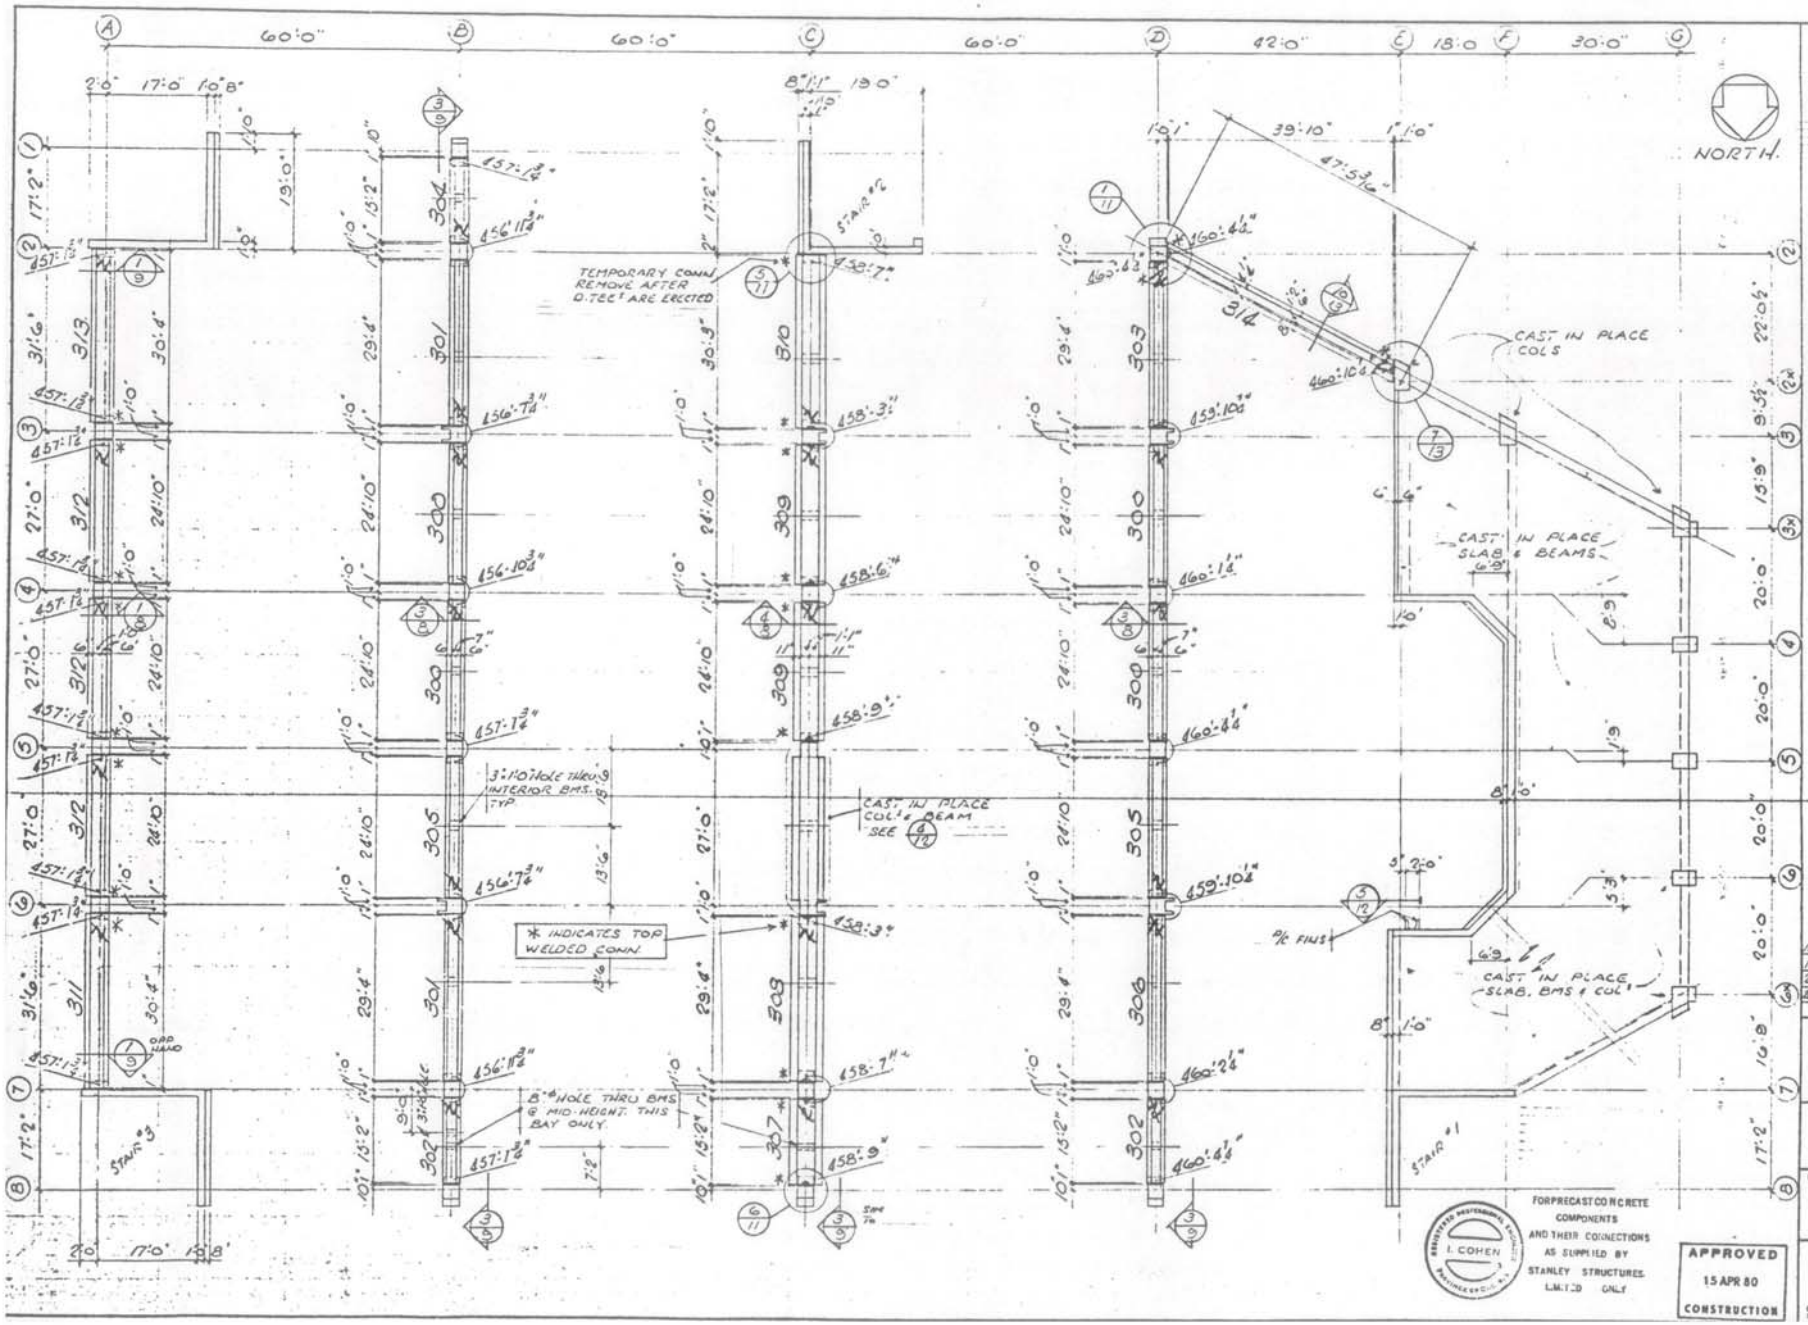

RECEIVED
DEC 24
MARSHALL MACKLIN MONAGHAN LIMITED

3898

ISSUED	#3	-	ERECTION	
17.3.80	#3	GM	RECORDS & WORKING	
25.2.80	#2	GM	APPR!	
28/1/80	#1		APPROVAL	
DATE	ISSUE	REV No.	DESCRIPTION	CHECK

STANLEY
Stanley Structures Limited
Bolleville (613) 962-4367

JOB: NORTH YORK GENERAL HOSPITAL PARKING DECK

DETAIL: MID LEVEL BEAM LAYOUT

DETAIL NO. | DRAWN BY: M. | CHK: I.C. | DATE: JAN 80
CHECKED BY | REVISION
DETAIL REFERENCE SHEET NO. SHEET NO.
DRAWING NO. D-3469-2

I. COHEN

FORPRECAST CONCRETE COMPONENTS AND THEIR CONNECTIONS AS SUPPLIED BY STANLEY STRUCTURES LIMITED ONLY

APPROVED
15 APR 80
CONSTRUCTION

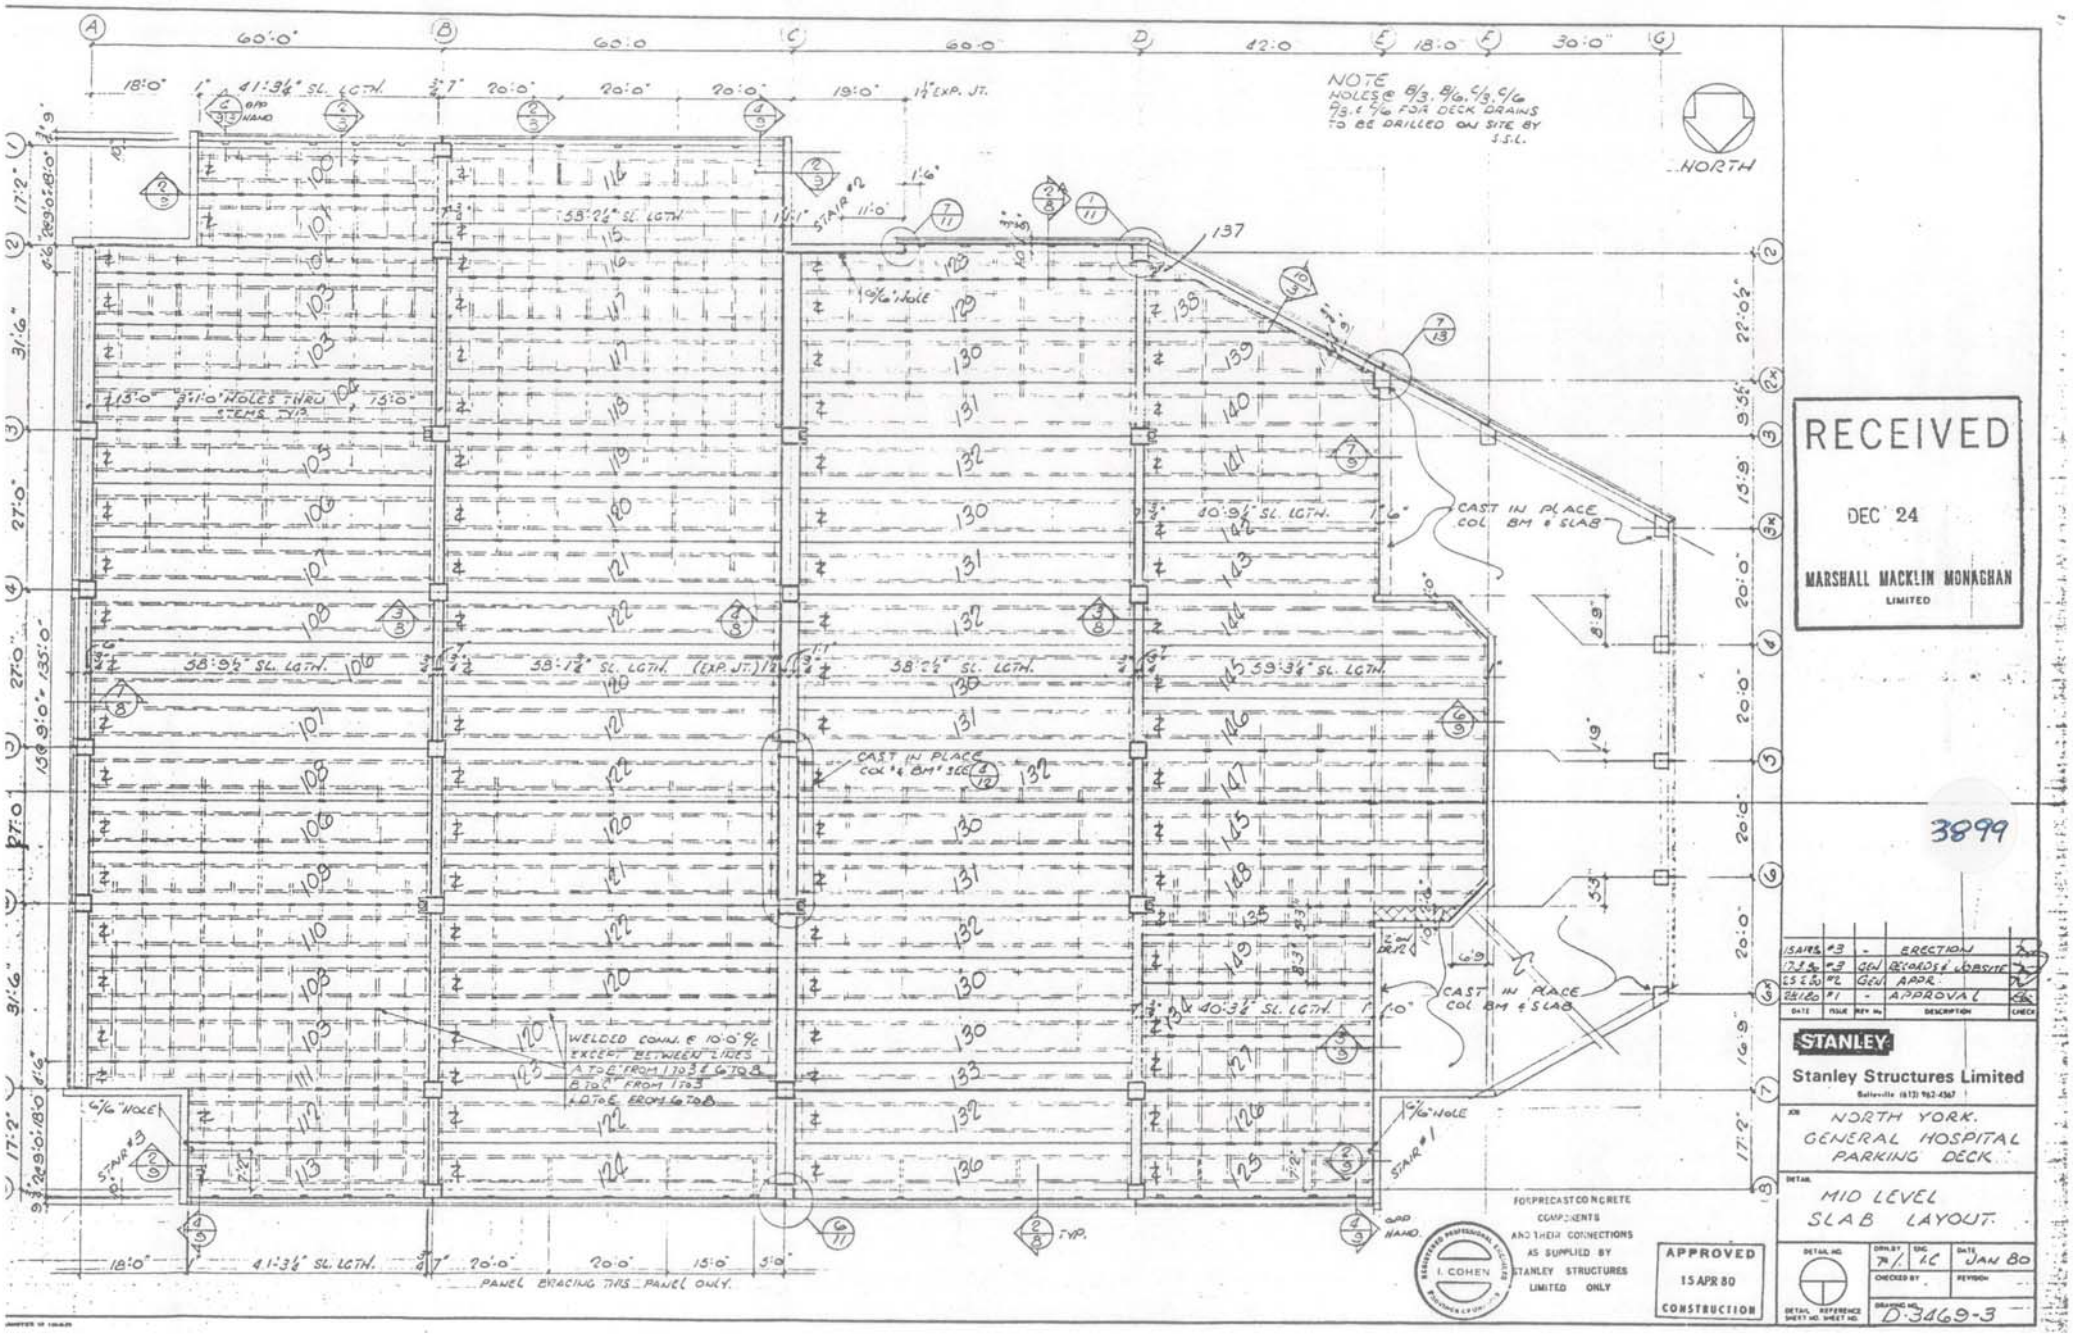
NOTE
HOLES @ 8/3, 8/6, 6/3, 6/6
& 6"ø FOR DECK DRAINS
TO BE DRILLED ON SITE BY
S.S.L.
NORTH
STAIR #2
STAIR #1
STAIR #3
CAST IN PLACE
COL. BM & SLAB
WELDED CONN. @ 10'-0" c/c
EXCEPT BETWEEN LINES
A TO E FROM 103 & 108
B TO C FROM 103
& D TO E FROM 6 TO 8
PANEL BRACING THIS PANEL ONLY.
TYP.
FOR PRECAST CONCRETE
COMPONENTS
AND THEIR CONNECTIONS
AS SUPPLIED BY
STANLEY STRUCTURES
LIMITED ONLY
I. COHEN
APPROVED
15 APR 80
CONSTRUCTION
RECEIVED
DEC 24
MARSHALL MACKLIN MONAGHAN
LIMITED
3899
STANLEY
Stanley Structures Limited
NORTH YORK.
GENERAL HOSPITAL
PARKING DECK.
MID LEVEL
SLAB LAYOUT.
JAN 80
D-3469-3

RECEIVED
DEC 24
MARSHALL MACKLIN MONAGHAN
LIMITED

NORTH

NOTE: ELEV. SHOWN THUS ARE TO U/SIDE OF BASE PL'S

CAST IN PLACE COL.

CAST IN PLACE COLS & WALL. SEE 4/12

TYP. SECTION @ COL. BASE PL

TYPE 'A', TYPE 'C' AS NOTED

TYPE 'B'

FILLS WERE REQ'D

CONC. PROTECTION (FOR A/BOLTS) BY OTHERS

1" ϕ A/BOLTS L/S SUPP BY S.S.L. & INST. BY OTHERS

1-2"ϕ 4" WINGS ON COL TYPE 'C'

FORM CAST CONCRETE COMPONENTS

APPROVED
15 APR 80
CONSTRUCTION

C4-7

DATE	ISSUE	REV. No	DESCRIPTION	CHECK
15 APR 80	#2	-	ERECTION	
17.3.80	#1	GEN	RECORDS & JOBSITE	
3.3.80	#3	GEN	JOBSITE (TYPE 'B' REVISED)	
25.2.80	#2	GEN	APPR	
25.1.80	#1	-	APPROVAL	

STANLEY
Stanley Structures Limited
Belleville (613) 962-4567

JOB: NORTH YORK GENERAL HOSPITAL PARKING DECK.

DETAIL: COLUMN & ANCHOR BOLT LAYOUT.

DETAIL NO. | DRN BY TH | CHG. I.C. | DATE JAN 80.
CHECKED BY | REVISION
DETAIL REFERENCE SHEET NO. SHEET NO.
DRAWING NO. D-3469-1.

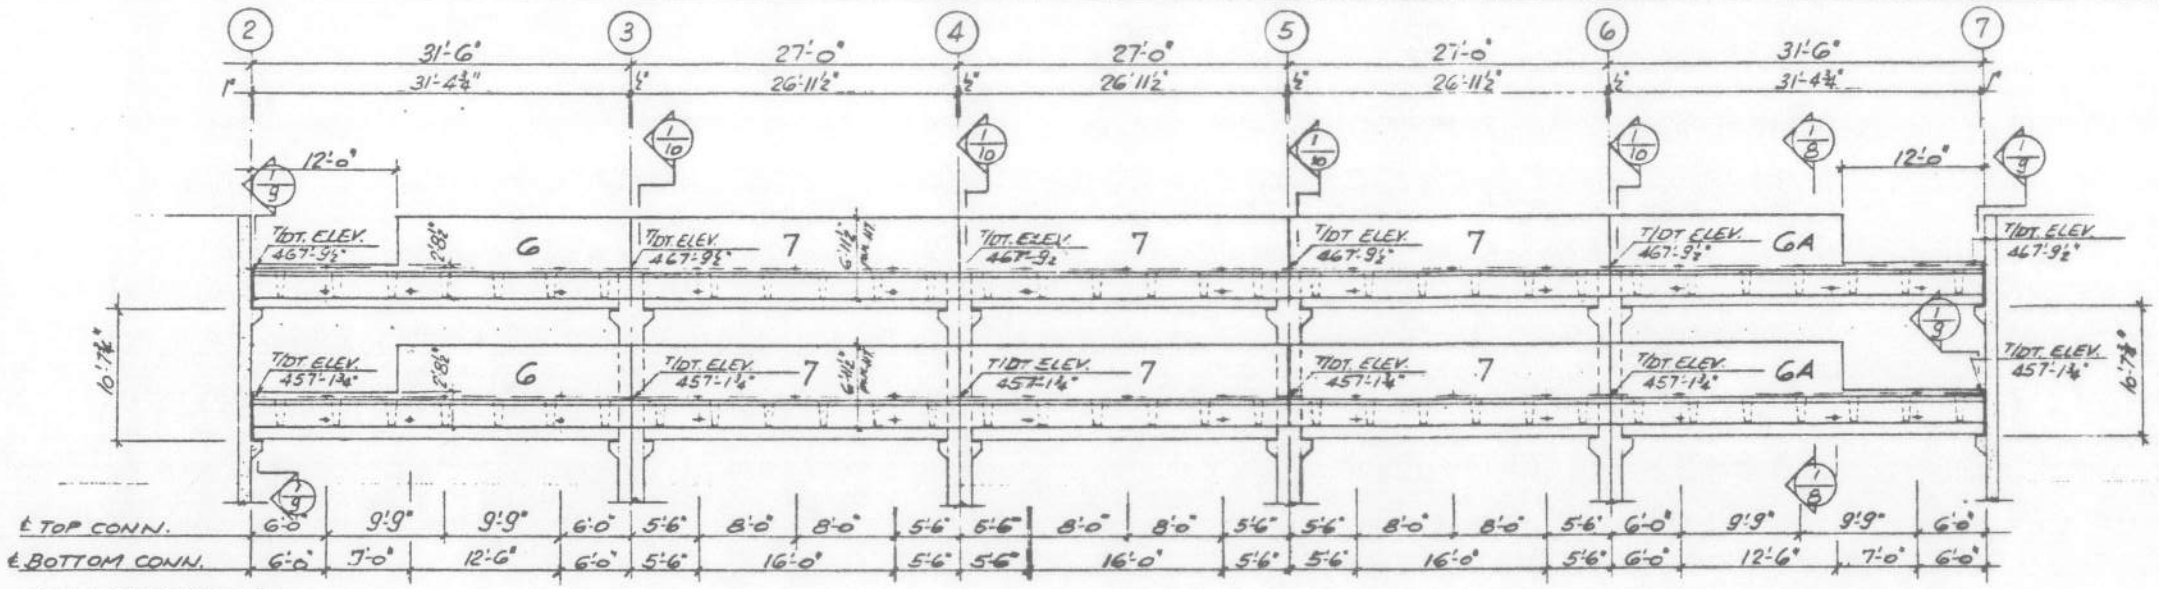

EAST ELEVATION
ALONG LINE 'A'

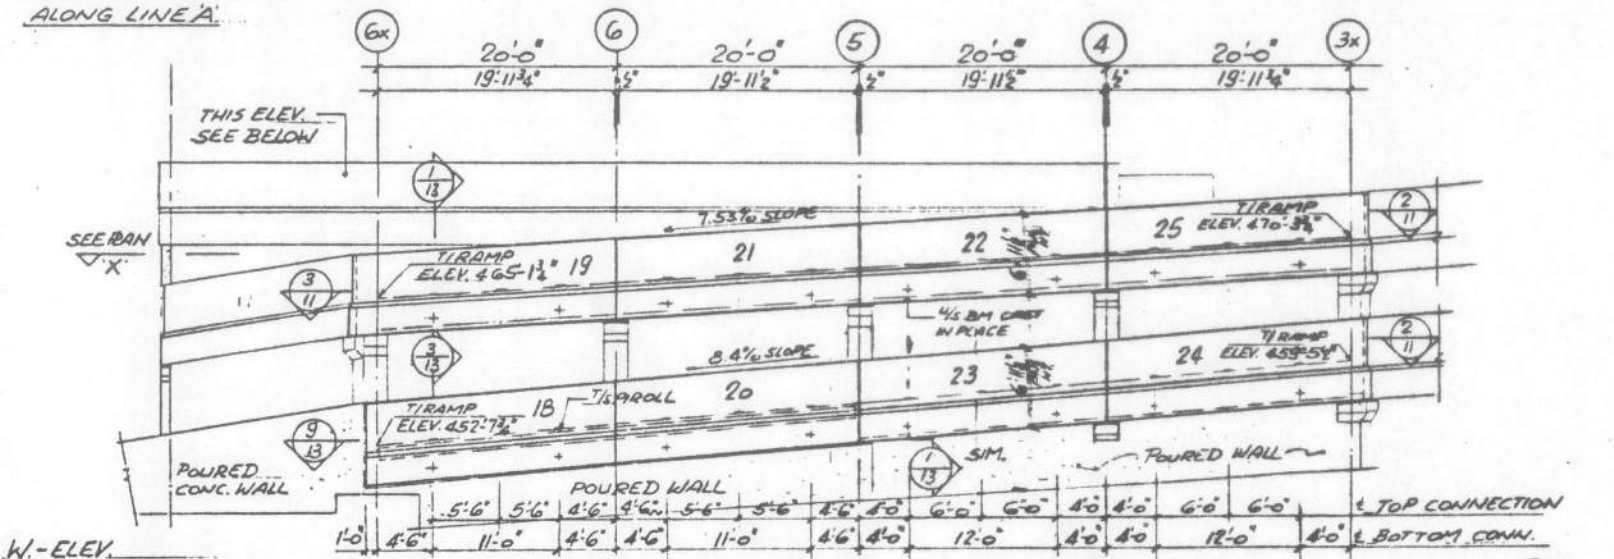

W. - ELEV.
ALONG 'G'

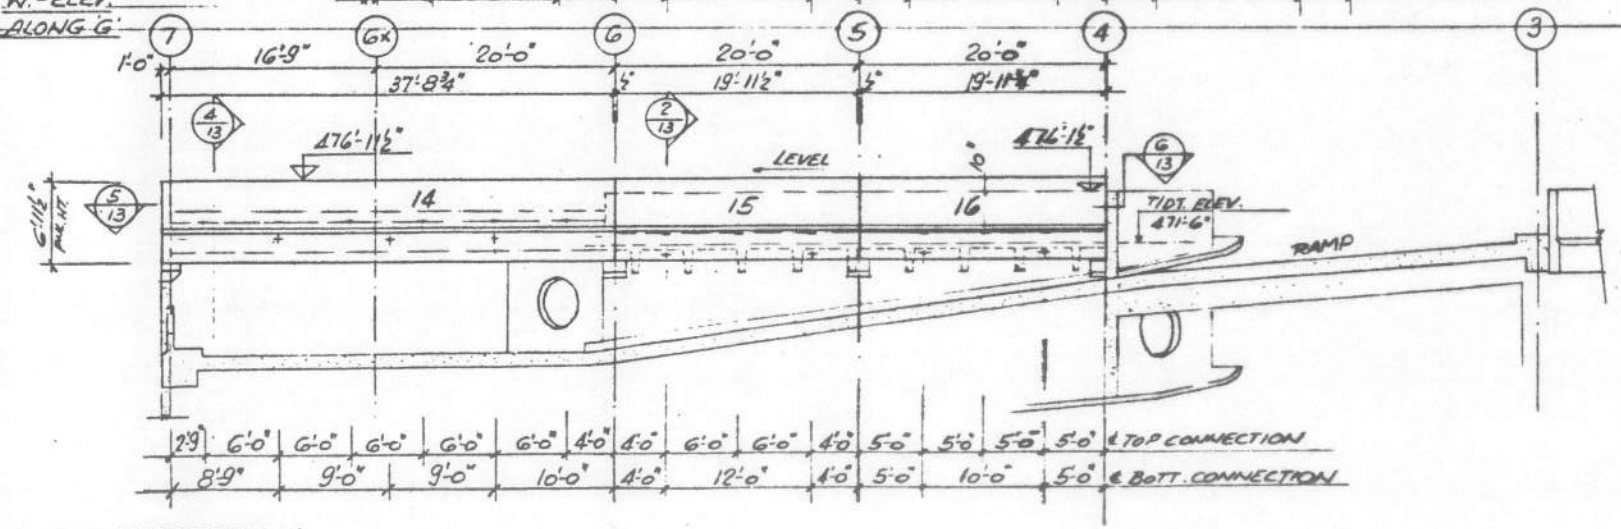

WEST ELEVATION
ALONG LINE 'F & G'

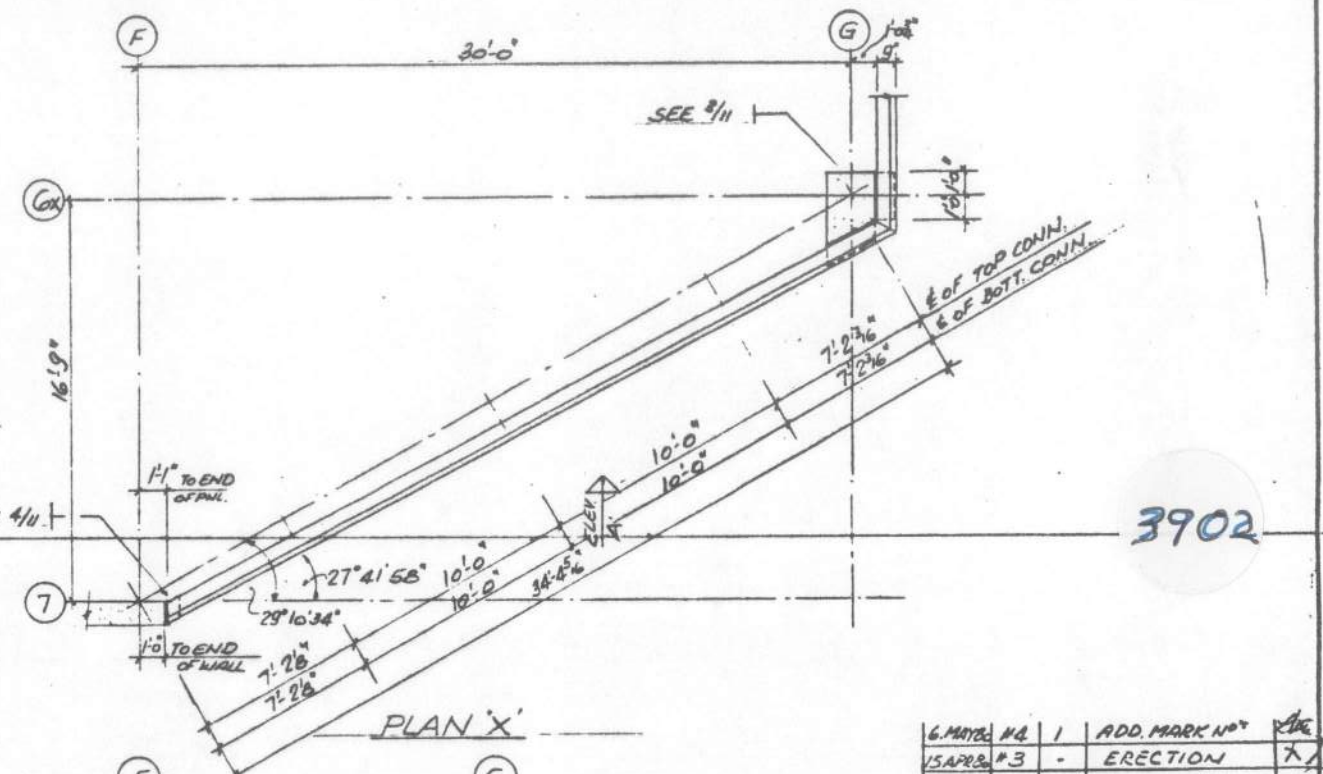

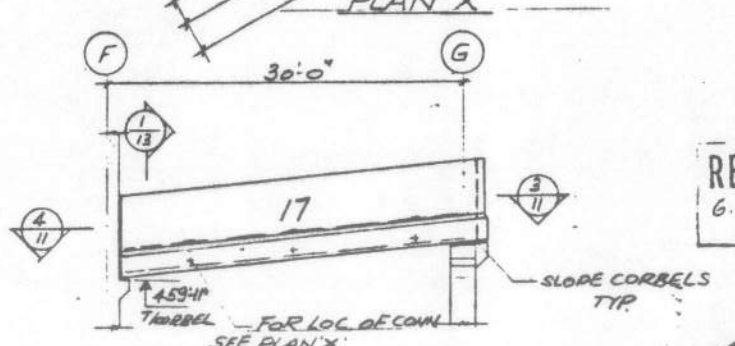

ELEVATION 'A'

FOR PRECAST CONCRETE COMPONENTS AND THEIR CONNECTIONS AS SUPPLIED BY STANLEY STRUCTURES LIMITED ONLY

RECEIVED
DEC 24
MARSHALL MACKLIN MONAGHAN LIMITED

REVISED
6. MAY 1980

APPROVED
15 APR 80
CONSTRUCTION

I. COHEN
REGISTERED PROFESSIONAL ENGINEER
PROVINCE OF ONTARIO

DATE	ISSUE	REV. No.	DESCRIPTION	CHECK
6.MAY.80	#4	1	ADD. MARK N°'s	
15.APR.80	#3	-	ERECTION	
17.3.80	#3	GEN	RECORDS & BASIS TS	
25.2.80	#2	-	FOR RE-APPROVAL	
25.1.80	#1	-	FOR APPROVAL	

STANLEY
Stanley Structures Limited
Belleville (613) 962-4567

JOB
NORTH YORK GENERAL HOSPITAL PARKING DECK

DETAIL
PANEL ELEVATIONS

DETAIL NO. — DETAIL REFERENCE SHEET NO. SHEET NO.

DRN. BY	ENG.	DATE
L.Hu	I.C.	JAN. 80
CHECKED BY		REVISION

DRAWING NO. D-3169-6

3902

NOTE:
2"x4" DUCTS @ COL/BM CONN TO BE FILLED WITH VERMICULITE BY S.S.L.

NORTH

TEMPORARY CONN REMOVE AFTER D.TEE'S ARE ERECTED

* INDICATES TOP WELDED CONN.

3-1'0" HOLE THRU INTERIOR BMS: TYP.

8"ø HOLE THRU BMS @ MID-HEIGHT. THIS BAY ONLY.

CAST IN PLACE COL'S & BEAM SEE 6/12

CAST IN PLACE COLS

CAST IN PLACE SLAB & BEAMS

CAST IN PLACE SLAB, BMS & COL'S

P/C FINS

STAIR #1

STAIR #2

STAIR #3

FOR PRECAST CONCRETE COMPONENTS AND THEIR CONNECTIONS AS SUPPLIED BY STANLEY STRUCTURES LIMITED ONLY

I. COHEN — REGISTERED PROFESSIONAL ENGINEER — PROVINCE OF ONTARIO

APPROVED
15 APR 80
CONSTRUCTION

RECEIVED
DEC 24
MARSHALL MACKLIN MONAGHAN LIMITED

3898

DATE	ISSUE	REV No.	DESCRIPTION	CHECK
15APR80	#3	-	ERECTION	
17.3.80	#3	GEN	RECORDS & VOBSITE	
25.2.80	#2	GEN	APPR:	
28.1.80	#1		APPROVAL.	

STANLEY
Stanley Structures Limited
Belleville (613) 962-4367

JOB: NORTH YORK GENERAL HOSPITAL PARKING DECK

DETAIL: MID LEVEL BEAM LAYOUT

DETAIL NO	DRN. BY	CHK.	DATE
	D.Y.	I.C.	JAN 80
DETAIL REFERENCE SHEET NO. SHEET NO.	CHECKED BY	REVISION	
	DRAWING NO. D-3469-2		

NOTE
HOLES @ B/3, B/6, C/3, C/6
F/3, E/6 FOR DECK DRAINS
TO BE DRILLED ON SITE BY
S.S.L.

NORTH

RECEIVED
DEC 24
MARSHALL MACKLIN MONAGHAN
LIMITED

3899

15 APR 80	#3	-	ERECTION	
17 MAR 80	#3	GEN	RECORDS & JOBSITE	
25 FEB 80	#2	GEN	APPR.	
24 JAN 80	#1	-	APPROVAL	
DATE	ISSUE	REV. No.	DESCRIPTION	CHECK

STANLEY
Stanley Structures Limited
Belleville (613) 962-4567

JOB
NORTH YORK.
GENERAL HOSPITAL
PARKING DECK.

DETAIL
MID LEVEL
SLAB LAYOUT.

DETAIL NO.	DRN. BY	ENG.	DATE
DETAIL REFERENCE SHEET NO. SHEET NO.	TV.	I.C	JAN 80
	CHECKED BY		REVISION
	DRAWING NO. D-3469-3		

FOR PRECAST CONCRETE COMPONENTS AND THEIR CONNECTIONS AS SUPPLIED BY STANLEY STRUCTURES LIMITED ONLY

REGISTERED PROFESSIONAL ENGINEER I. COHEN PROVINCE OF ONTARIO

APPROVED
15 APR 80
CONSTRUCTION

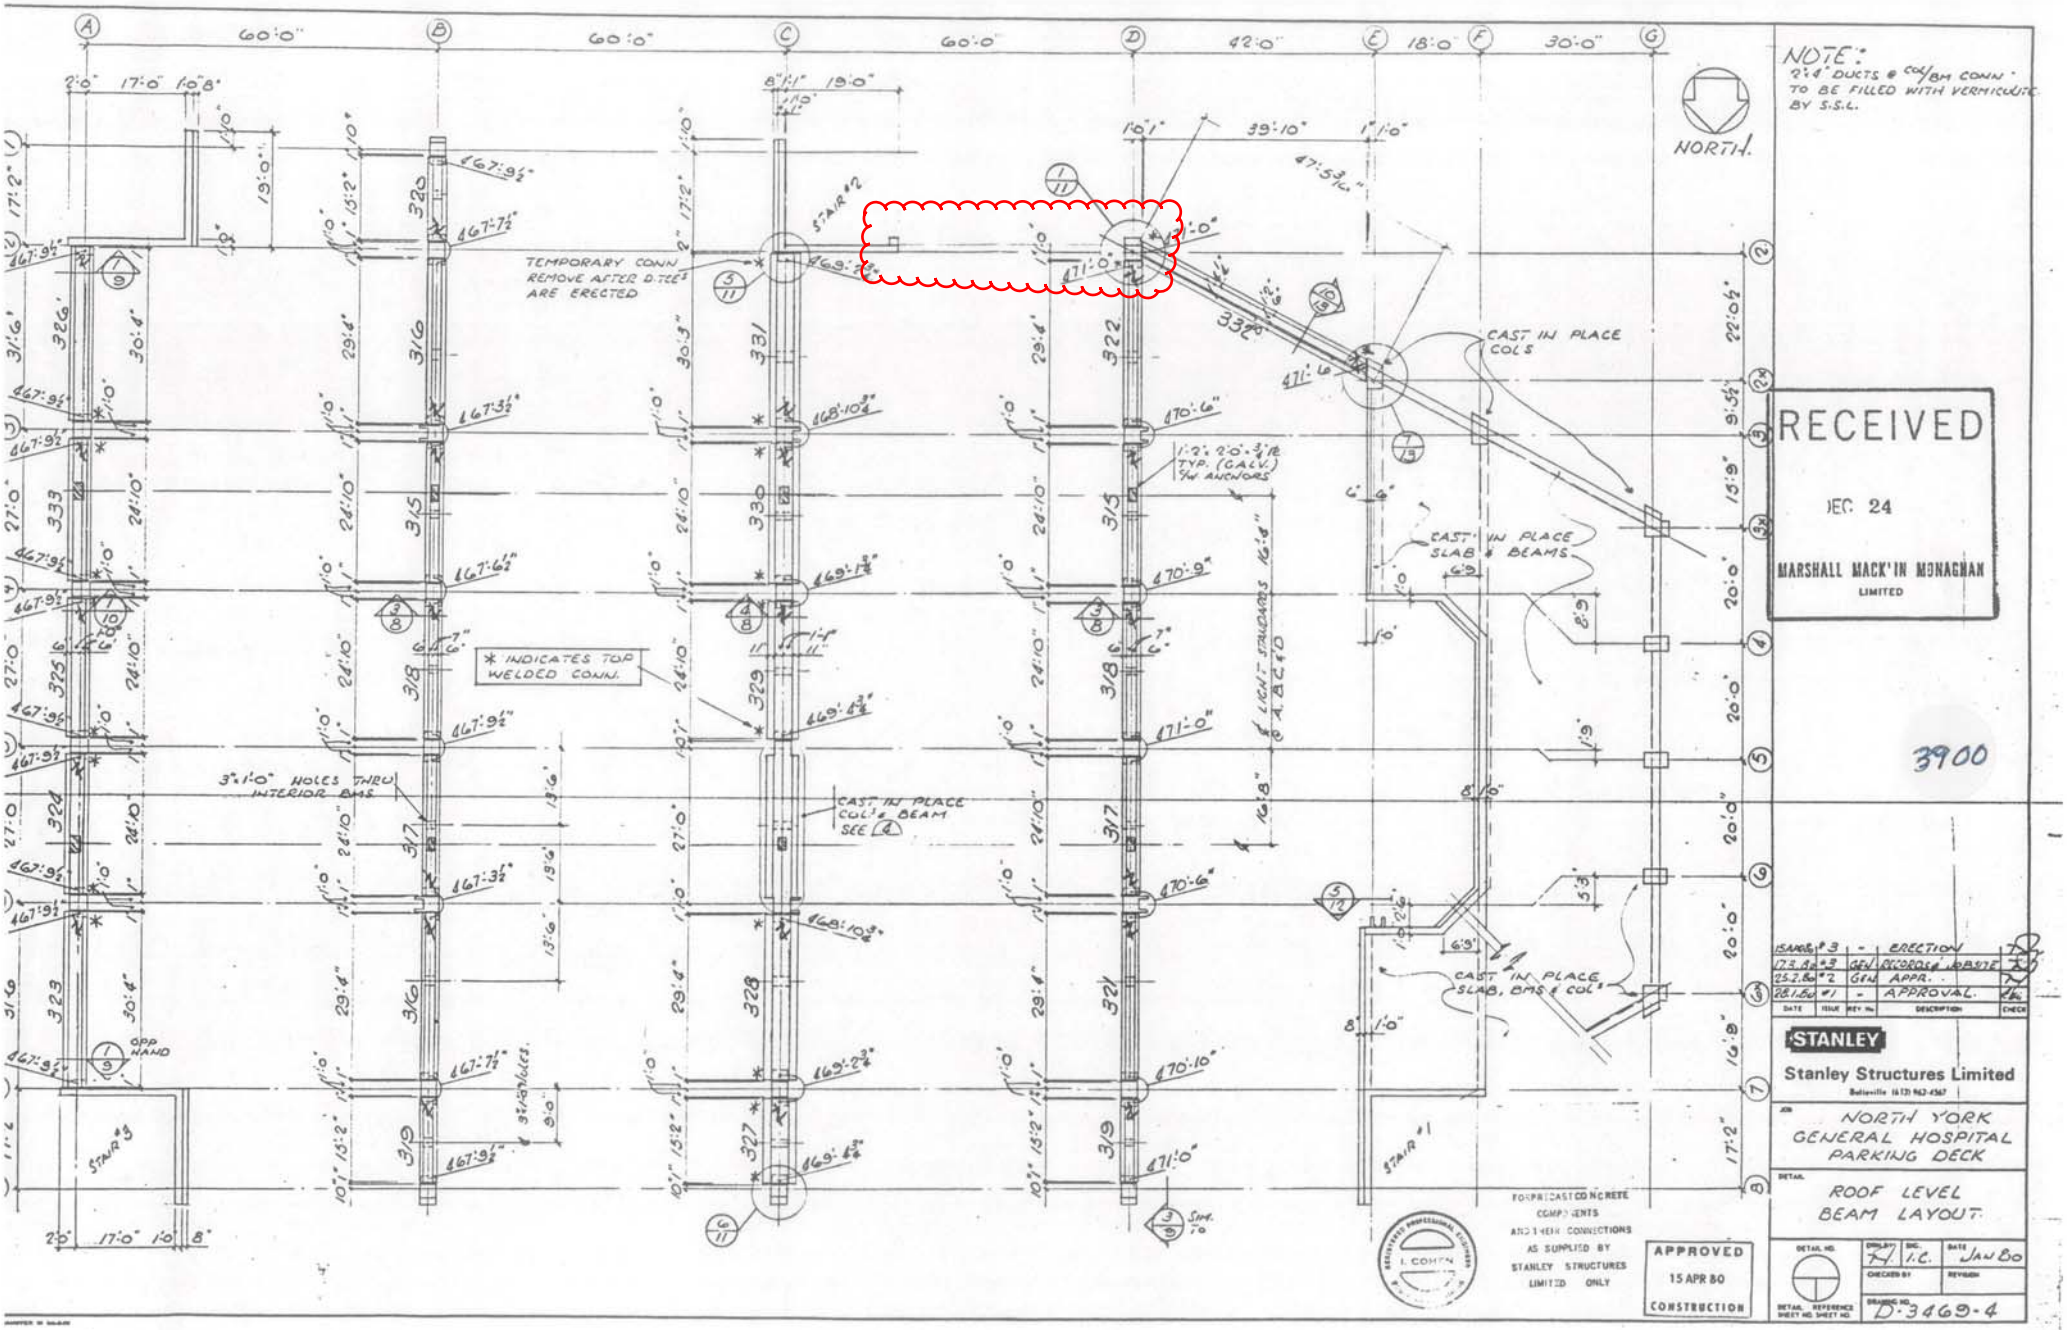

RECEIVED
DEC 24
MARSHALL MACKLIN MONAGHAN LIMITED

3900

ISSUED # 3	-	ERECTION	
173.80 #3	GEN	REVISIONS & UPDATE	
25.2.80 #2	GEN	APPR.	
28.1.80 #1	-	APPROVAL.	
DATE	ISSUE	DESCRIPTION	CHECK

STANLEY
Stanley Structures Limited
Belleville (613) 962-4567

JOB: NORTH YORK GENERAL HOSPITAL PARKING DECK

DETAIL: ROOF LEVEL BEAM LAYOUT

DETAIL NO.	DRAWN	SEC.	DATE
	M	I.C.	JAN 80
DETAIL REFERENCE SHEET NO. SHEET NO.	CHECKED BY	REVISION	
	DRAWING NO. D-3469-4		

FOR PRECAST CONCRETE COMPONENTS AND THEIR CONNECTIONS AS SUPPLIED BY STANLEY STRUCTURES LIMITED ONLY

APPROVED
15 APR 80
CONSTRUCTION

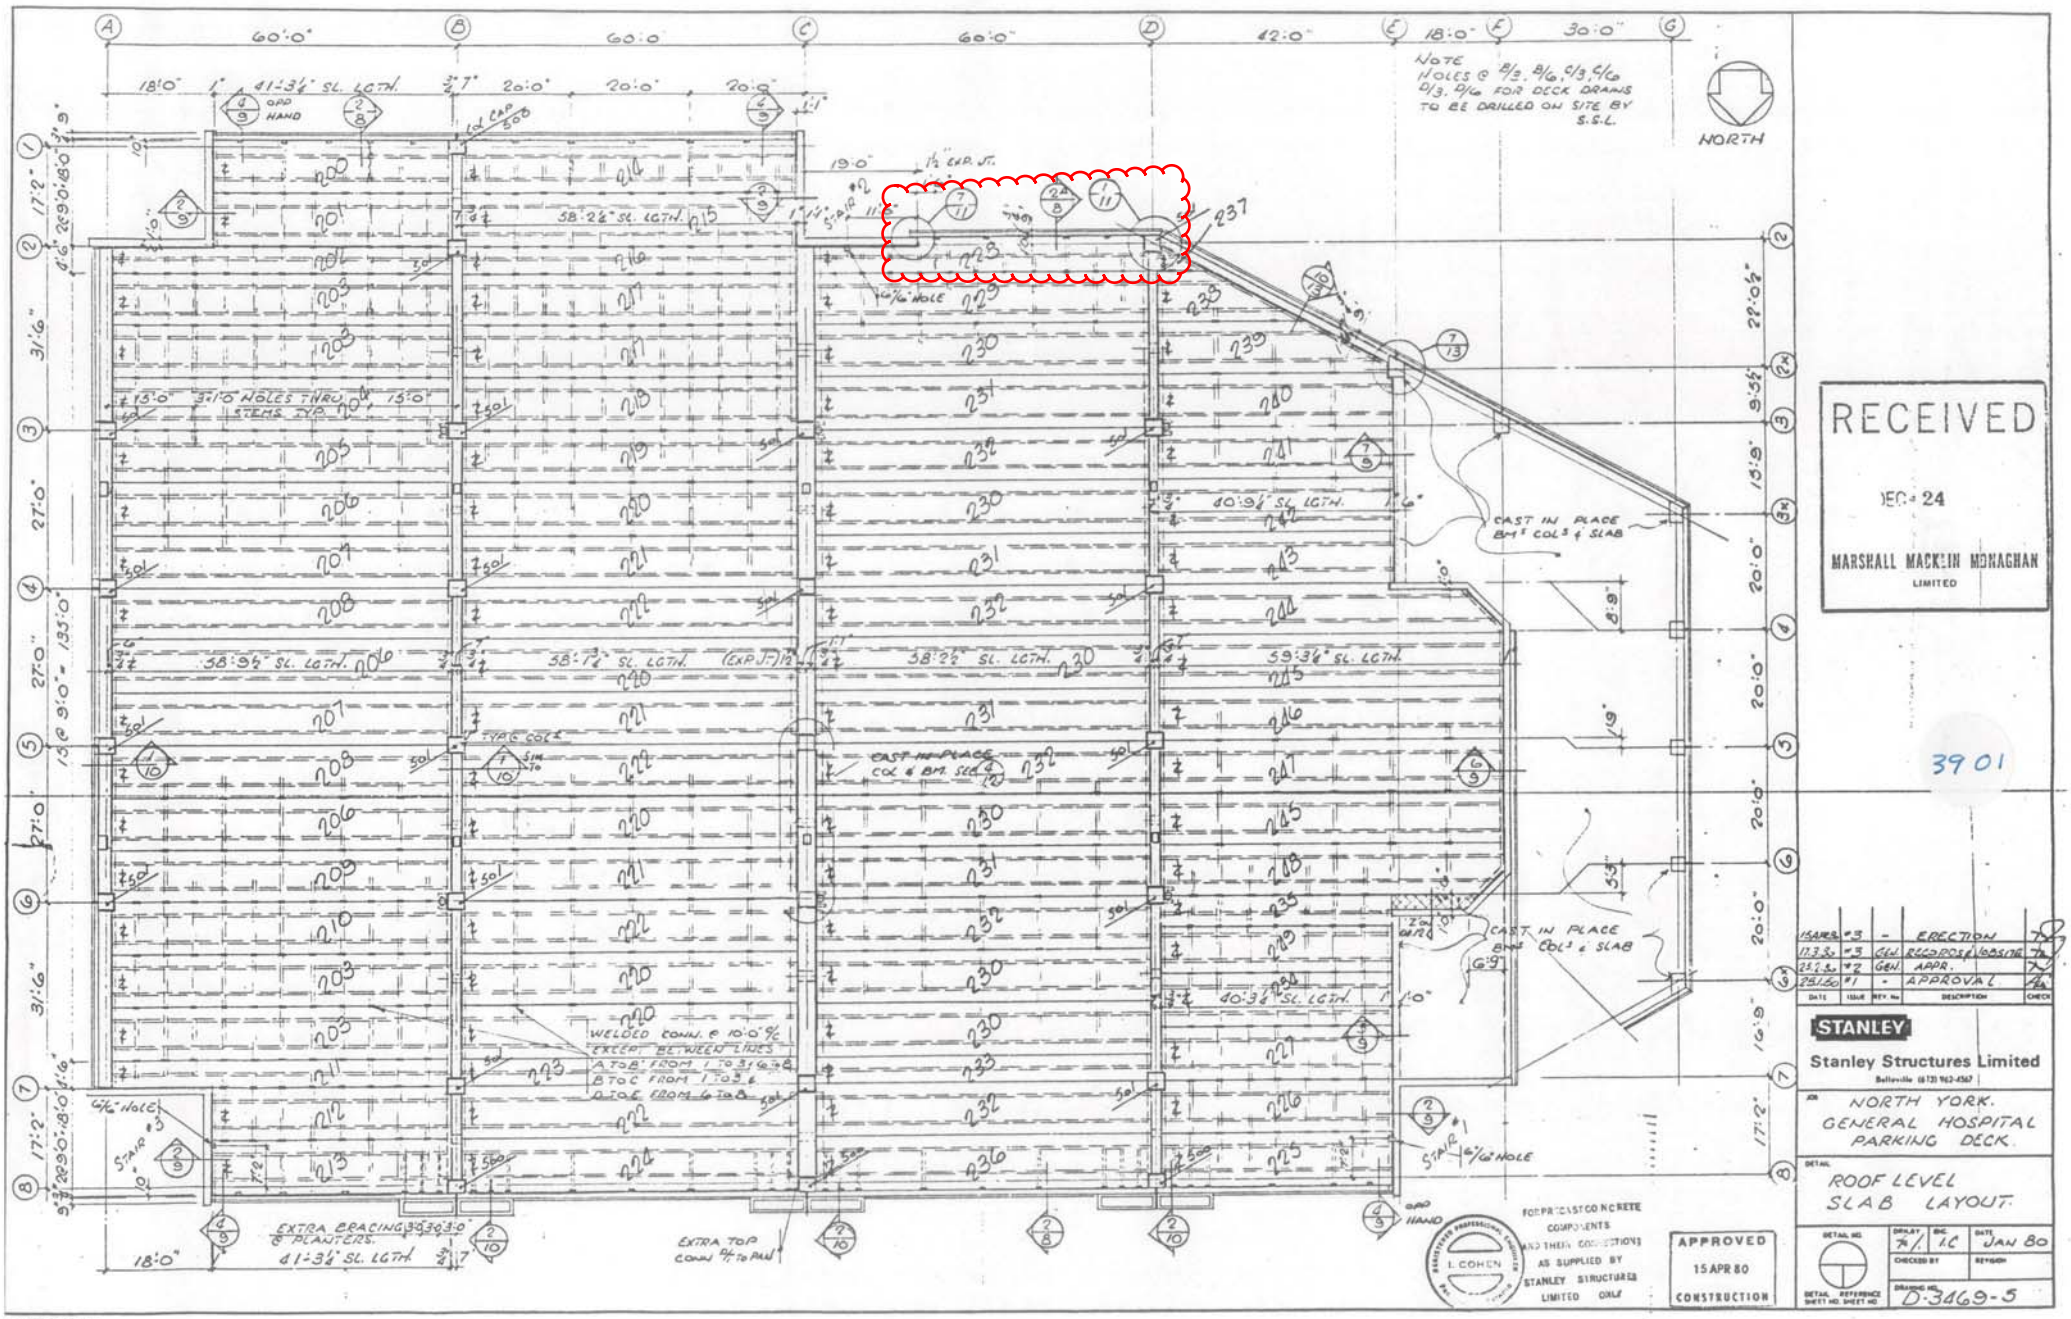
NOTE HOLES @ B/3, B/6, C/3, C/6 D/3, D/6 FOR DECK DRAINS TO BE DRILLED ON SITE BY S.S.L.
NORTH
RECEIVED
DEC 24
MARSHALL MACKLIN MONAGHAN LIMITED
3901
CAST IN PLACE BM^S COLS & SLAB
CAST IN PLACE COL^S & SLAB
CAST IN PLACE COL & BM. SEC
EXTRA BRACING @ PLANTERS.
EXTRA TOP CONN @ TO PAN
WELDED CONN. @ 10'-0" c/c EXCEPT BETWEEN LINES A TO B: FROM 1 TO 3 & 6 TO 8 B TO C: FROM 1 TO 3 & 6 TO 8 D TO E: FROM 6 TO 8
FOR PRECAST CONCRETE COMPONENTS AND THEIR CONNECTIONS AS SUPPLIED BY STANLEY STRUCTURES LIMITED ONLY
I. COHEN
APPROVED
15 APR 80
CONSTRUCTION
ISSUED #3 - ERECTION
11.3.80 #3 GEN RECORDS/LOCATE
25.2.80 #2 GEN APPR.
29.1.80 #1 - APPROVAL
STANLEY
Stanley Structures Limited
Belleville (613) 962-4567
JOB NORTH YORK. GENERAL HOSPITAL PARKING DECK.
DETAIL ROOF LEVEL SLAB LAYOUT.
DRAWN TL CHK IC DATE JAN 80
CHECKED BY REVISION
DRAWING NO. D-3469-5

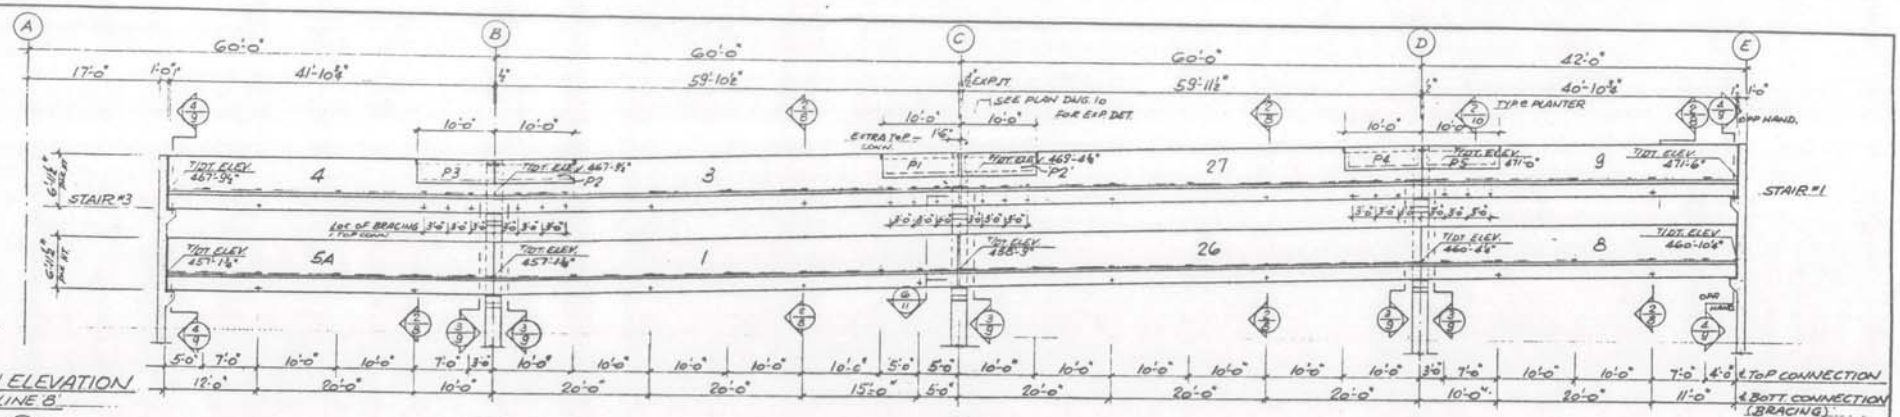

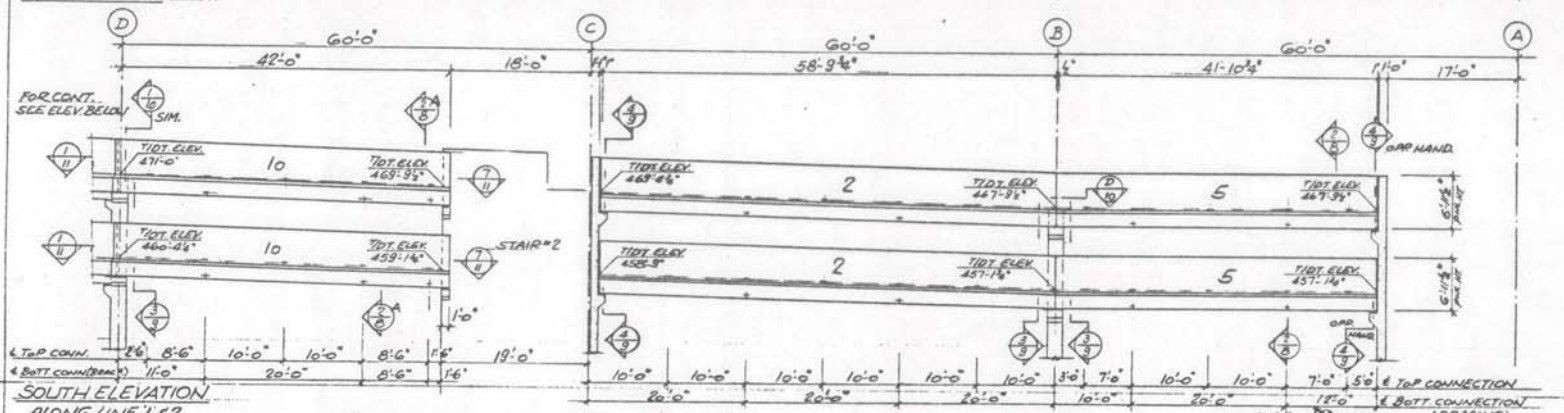

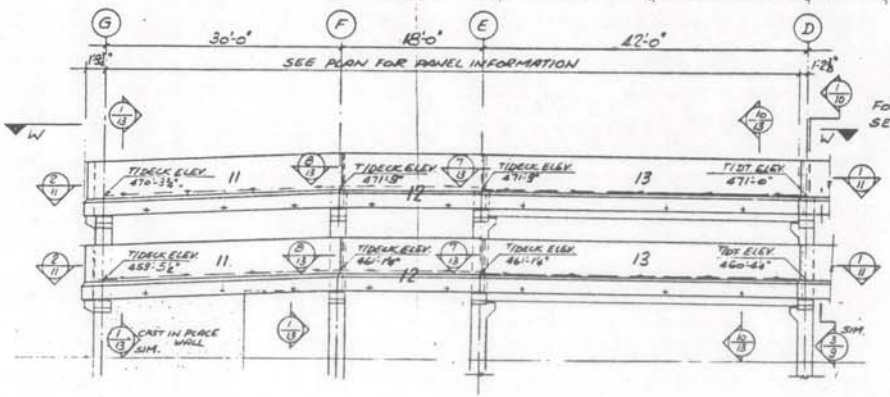

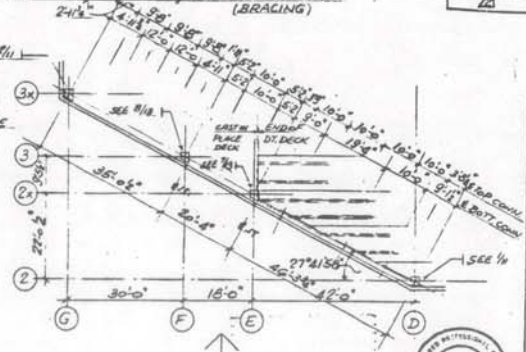

FOR PRECAST CONCRETE COMPONENTS AND THEIR CONNECTIONS AS SUPPLIED BY STANLEY STRUCTURES LIMITED ONLY

RECEIVED
FEB 24
MARSHALL MACKLIN MONAGHAN LIMITED

REVISED 5 JUN 1980

3903

5 JUN 80	#5	2	ADD MARK Nos PLANTER
4 MAY 80	#4	1	ADD MARK Nos
15 APR 80	#3	-	ERECTION
1 FEB 80	#2	GDN	RECORDS & JOBSITE
25 JAN 80	#2	-	FOR RE-APPROVAL
28 JAN 80	#1	-	FOR APPROVAL
DATE	ISSUE	REV No.	DESCRIPTION CHECK

STANLEY
Stanley Structures Limited
Belleville (613) 962-4567

JOB NORTH YORK GENERAL HOSPITAL PARKING DECK

DETAIL PANEL ELEVATIONS

I. COHEN

APPROVED 15 APR 80 CONSTRUCTION

DETAIL NO. | DRN BY | CHK. I.C. | DATE JAN. 1980
DETAIL REFERENCE SHEET NO. SHEET NO. | CHECKED BY | REVISION
DRAWING NO. D-3469-7

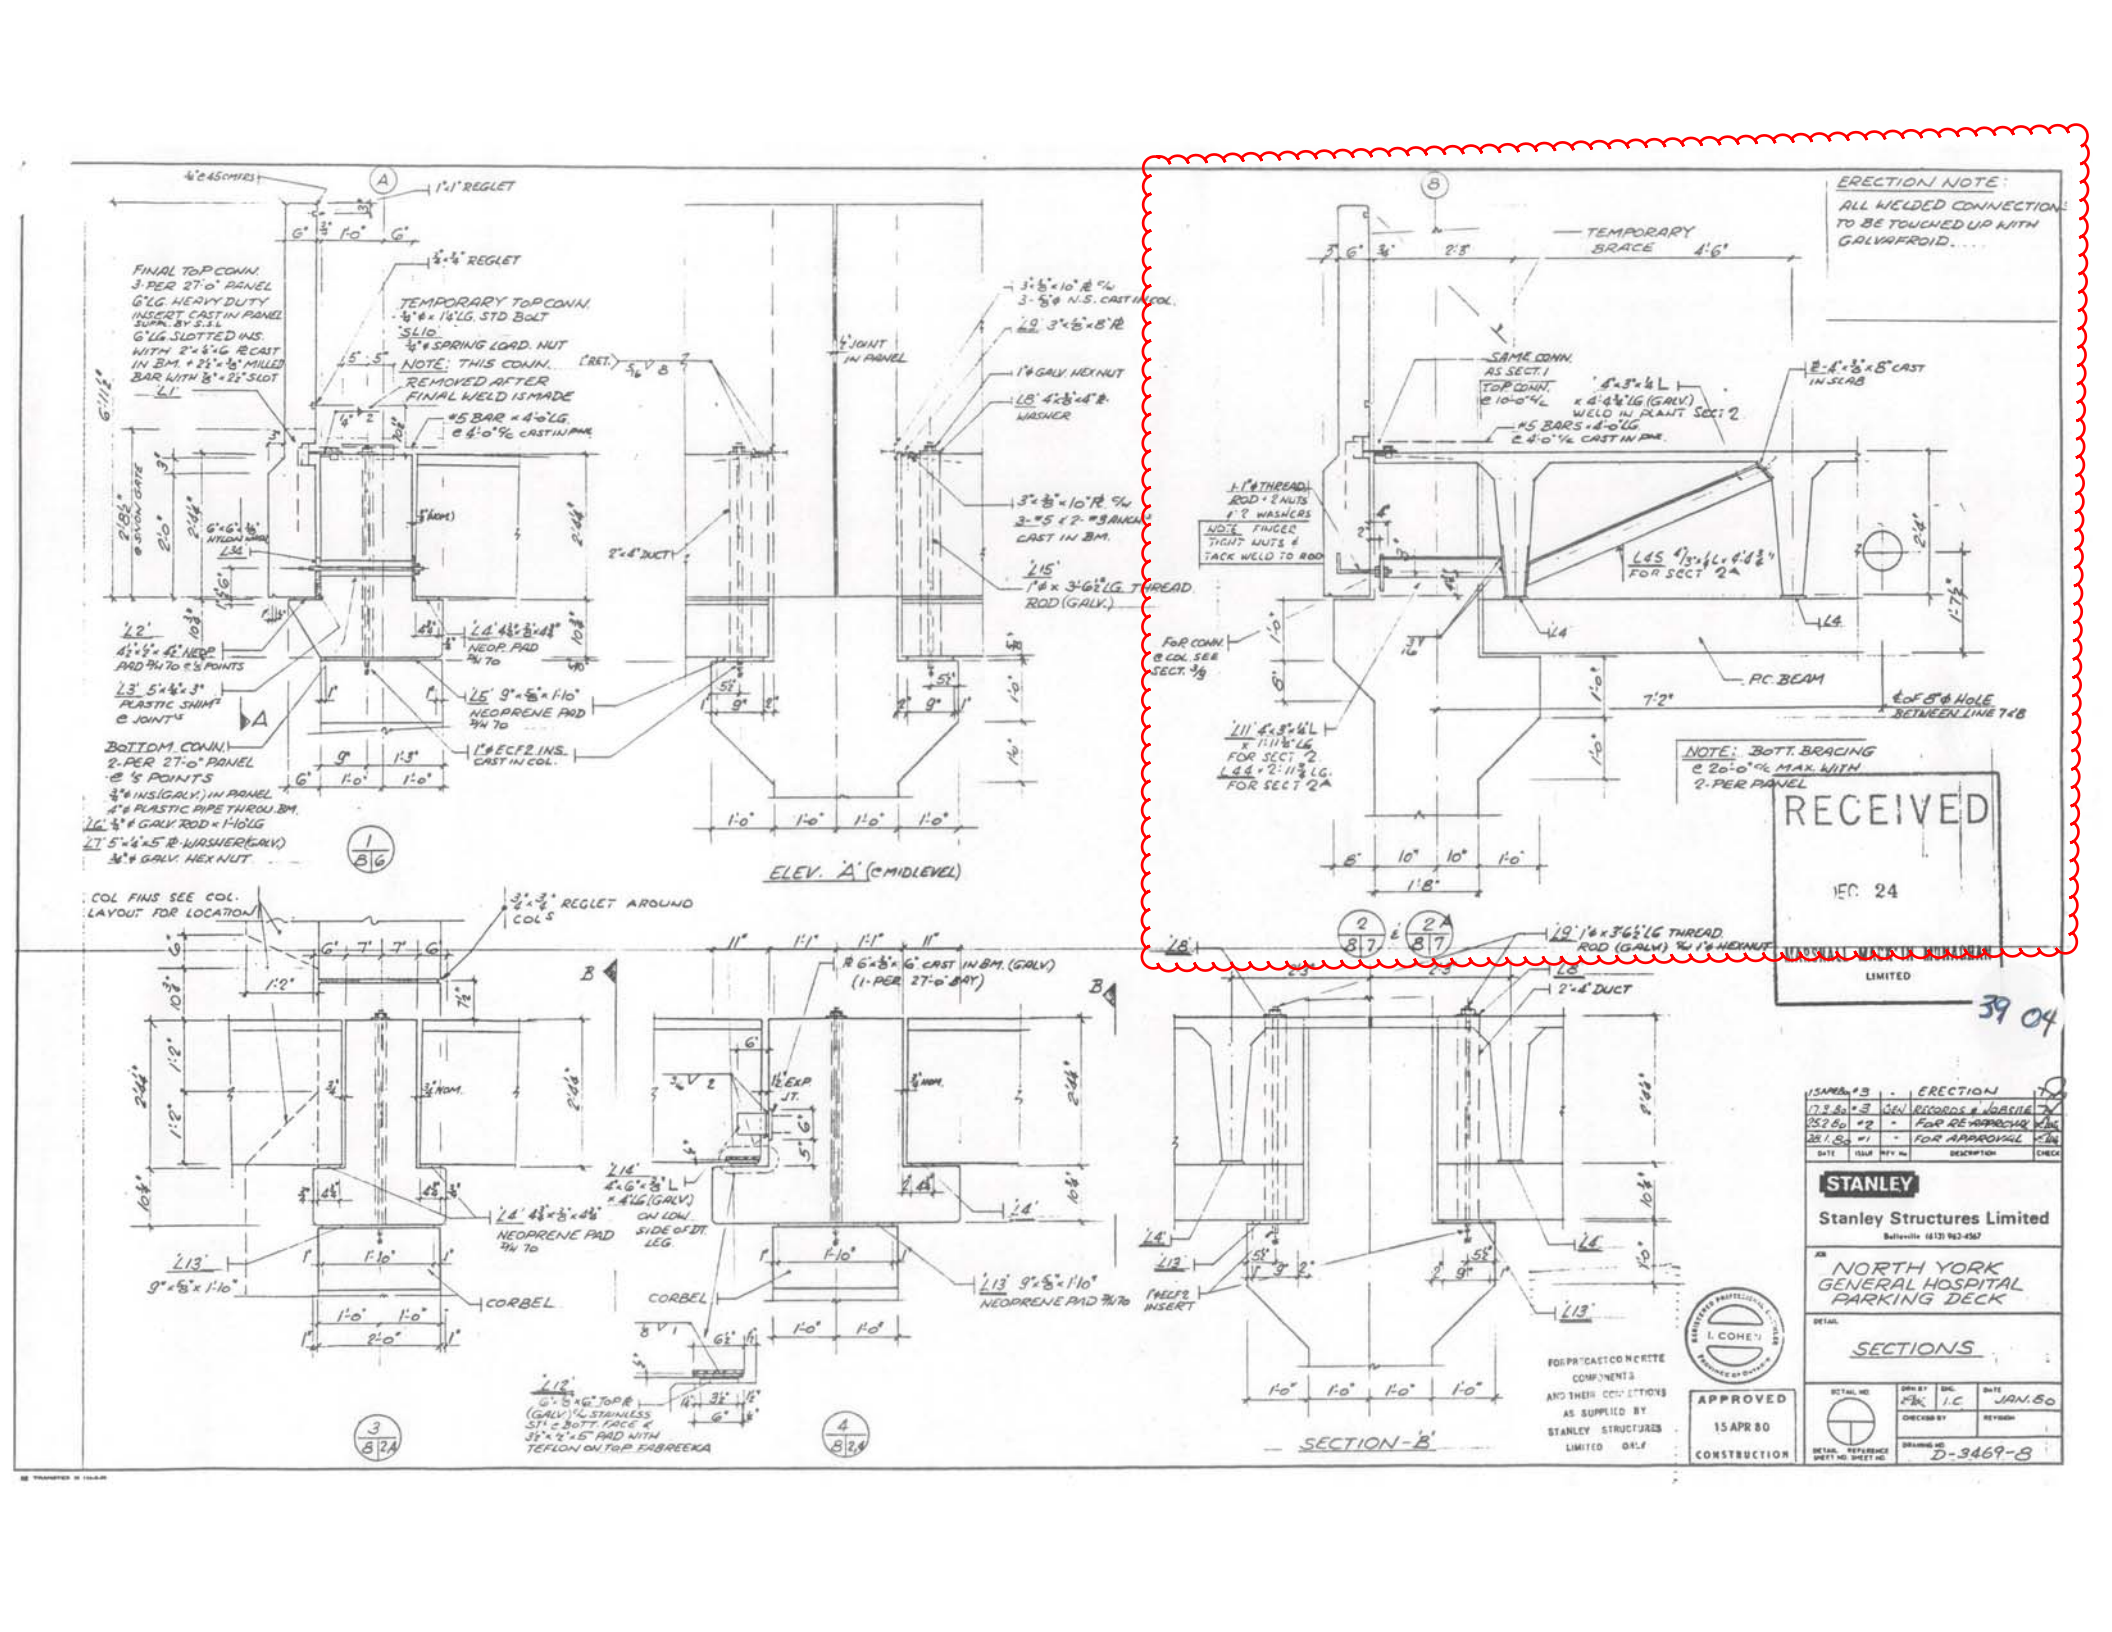
ELEV. 'A' (@ MIDLEVEL)
SECTION - B
ERECTION NOTE:
ALL WELDED CONNECTIONS TO BE TOUCHED UP WITH GALVAFROID.
RECEIVED
DEC 24
LIMITED
39 04
STANLEY
Stanley Structures Limited
NORTH YORK GENERAL HOSPITAL PARKING DECK
SECTIONS
APPROVED
15 APR 80
CONSTRUCTION
D-3469-8

NOTE:
2:4" DUCTS @ COL/BM CONN. TO BE FILLED WITH VERMICULITE BY S.S.L.

NORTH

TEMPORARY CONN REMOVE AFTER D.TEES ARE ERECTED

STAIR #2

CAST IN PLACE COLS

CAST IN PLACE SLAB & BEAMS

CAST IN PLACE SLAB, BMS & COLS

1'-2" x 2'-0" x 3/16 TYP. (GALV.) C/W ANCHORS

LIGHT STANDARDS A, B & C 40

* INDICATES TOP WELDED CONN.

3" x 1'-0" HOLES THRU INTERIOR BMS

CAST IN PLACE COL'S & BEAM SEE (4)

3" x 3" HOLES.

STAIR #3

OPP HAND

STAIR #1

SIM.

FORPRECAST CONCRETE COMPONENTS AND THEIR CONNECTIONS AS SUPPLIED BY STANLEY STRUCTURES LIMITED ONLY

REGISTERED PROFESSIONAL ENGINEER I. COHEN

APPROVED
15 APR 80
CONSTRUCTION

RECEIVED
DEC 24
MARSHALL MACKLIN MONAGHAN LIMITED

3900

DATE	ISSUE	REV No.	DESCRIPTION	CHECK
15APR80	#3	-	ERECTION	
17.3.80	#3	GEN	RECORDS & JOB SITE	
25.2.80	#2	GEN	APPR.	
28.1.80	#1	-	APPROVAL.	

STANLEY
Stanley Structures Limited
Belleville (613) 962-4567

JOB: NORTH YORK GENERAL HOSPITAL PARKING DECK

DETAIL: ROOF LEVEL BEAM LAYOUT

DETAIL NO.	DRN. BY	ENG.	DATE
DETAIL REFERENCE SHEET NO. SHEET NO.	M.	I.C.	JAN 80
	CHECKED BY		REVISION
	DRAWING NO. D-3469-4		

NOTE
HOLES @ B/3, B/6, C/3, C/6
D/3, D/6 FOR DECK DRAINS
TO BE DRILLED ON SITE BY
S.S.L.

NORTH

60'-0" | 60'-0" | 60'-0" | 42'-0" | 18'-0" | 30'-0"

18'-0" | 1" | 41'-3¼" SL. LGTH. | 3½" | 7" | 20'-0" | 20'-0" | 20'-0"

OPP HAND

1¢ CAP 500

19'-0" 1½" EXP. JT.

1'-6"

1'-1" SLOPE

11'-5"

6¢ HOLE

58'-2½" SL. LGTH.

15'-0" 3'-1'-0" HOLES THRU STEMS TYP. 15'-0"

50¢

38'-9½" SL. LGTH.

58'-7½" SL. LGTH.

(EXP. J.) 1½

58'-2½" SL. LGTH.

40'-9¼" SL. LGTH.

59'-3¼" SL. LGTH.

CAST IN PLACE BM'S COL'S & SLAB

8'-9"

5'-3"

CAST IN PLACE COL'S & SLAB

6'-9"

40'-3¾" SL. LGTH.

TYP. C COL'S

SIM TO

CAST IN PLACE COL & BM. SEE

WELDED CONN. @ 10'-0" c/c EXCEPT BETWEEN LINES
A TO B: FROM 1 TO 3 & 6 TO 8
B TO C: FROM 1 TO 3 &
D TO E: FROM 6 TO 8

6¢ HOLE

STAIR #3

STAIR #1

6¢/6¢ HOLE

EXTRA BRACING @ PLANTERS.

3'-0" 3'-0" 3'-0"

18'-0" 41'-3¼" SL. LGTH.

EXTRA TOP CONN ¾ TO PAN

OPP HAND

FOR PRECAST CONCRETE COMPONENTS AND THEIR CONNECTIONS AS SUPPLIED BY STANLEY STRUCTURES LIMITED ONLY

I. COHEN — REGISTERED PROFESSIONAL ENGINEER — PROVINCE OF ONTARIO

APPROVED
15 APR 80
CONSTRUCTION

RECEIVED
DEC 24
MARSHALL MACKLIN MONAGHAN
LIMITED

3901

ISS/REG	#3	-	ERECTION	
17.3.80	#3	GEN.	RECD POST/OBSITE	
25.2.80	#2	GEN.	APPR.	
29.1.80	#1	-	APPROVAL	
DATE	ISSUE	REV. No	DESCRIPTION	CHECK

STANLEY
Stanley Structures Limited
Belleville (613) 962-4567

JOB
NORTH YORK.
GENERAL HOSPITAL
PARKING DECK.

DETAIL
ROOF LEVEL
SLAB LAYOUT.

DETAIL NO. | DR'N BY | CHK'D BY | ENG. I.C | DATE JAN 80 | REVISION

DETAIL REFERENCE SHEET NO. SHEET NO.

DRAWING NO. D-3469-5

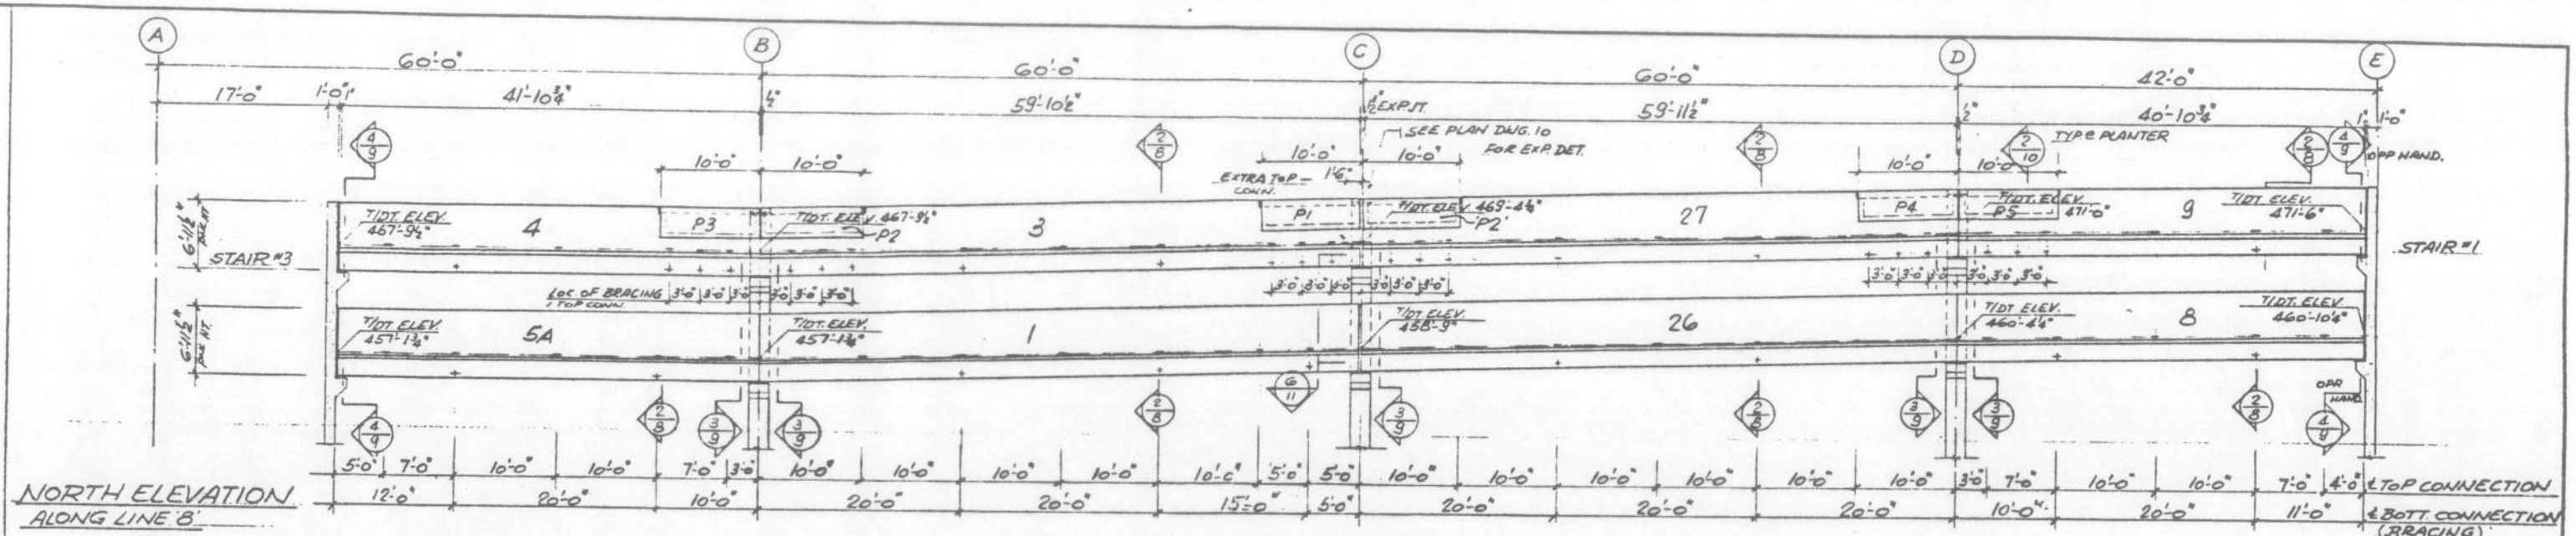

NORTH ELEVATION
ALONG LINE 'B'

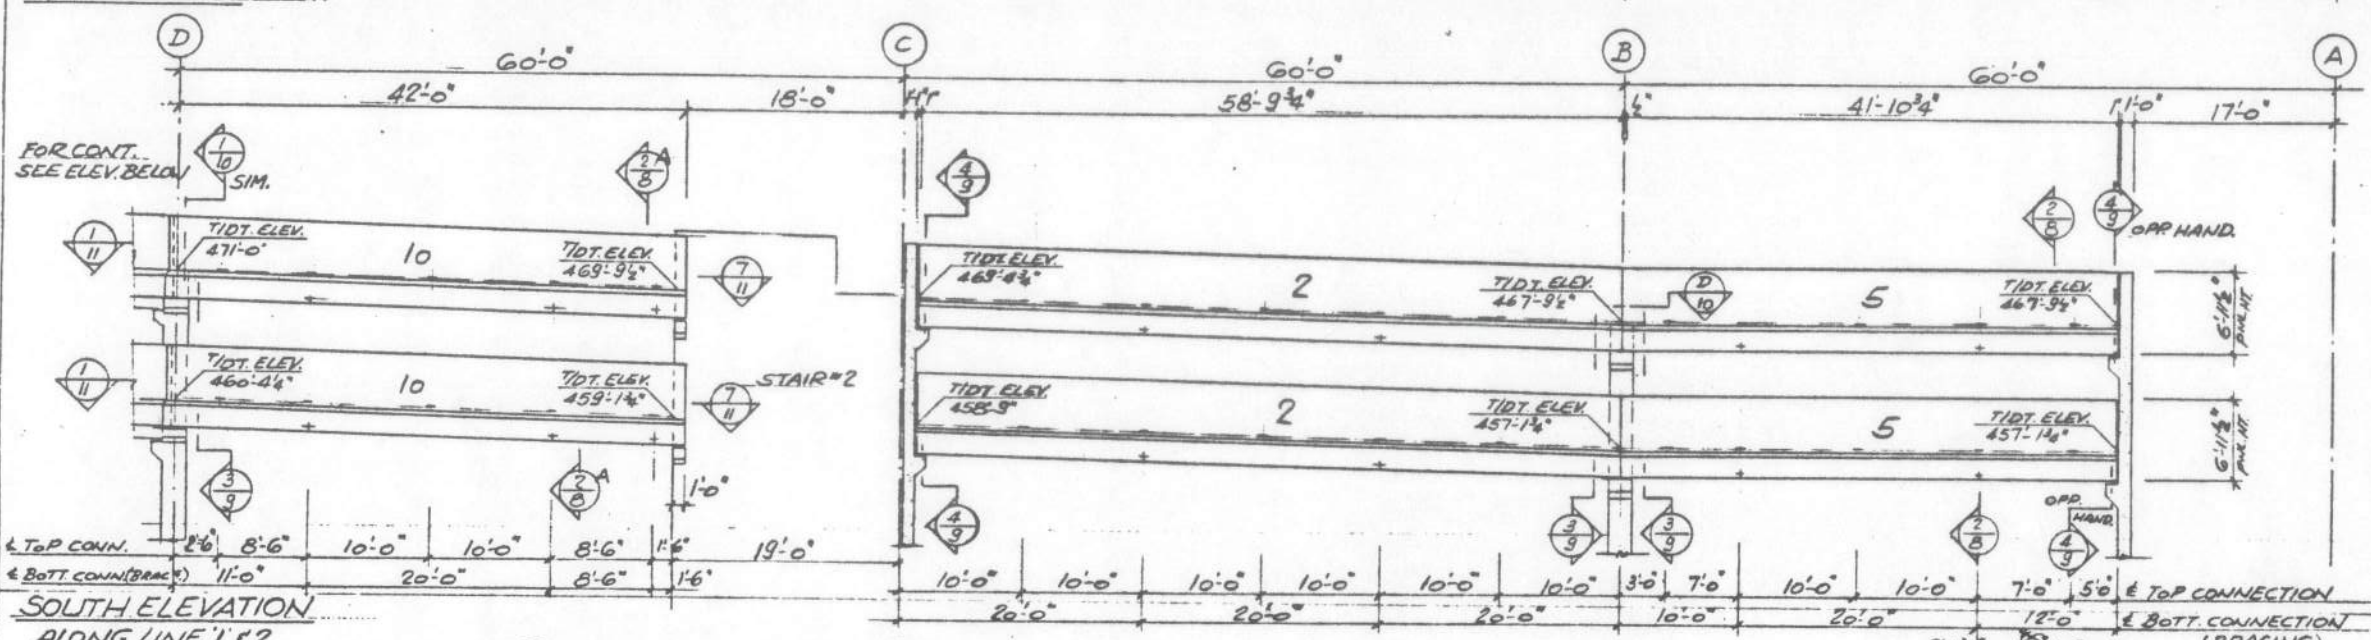

SOUTH ELEVATION
ALONG LINE '1' & '2'

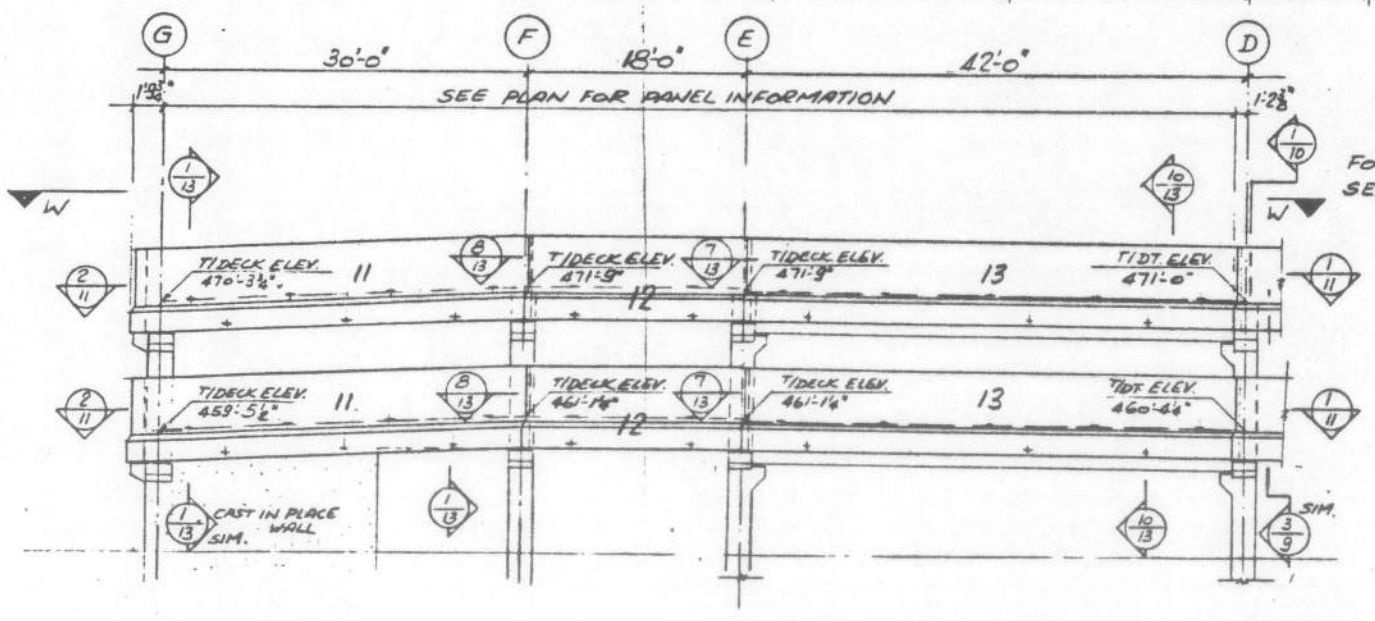

SOUTH ELEVATION

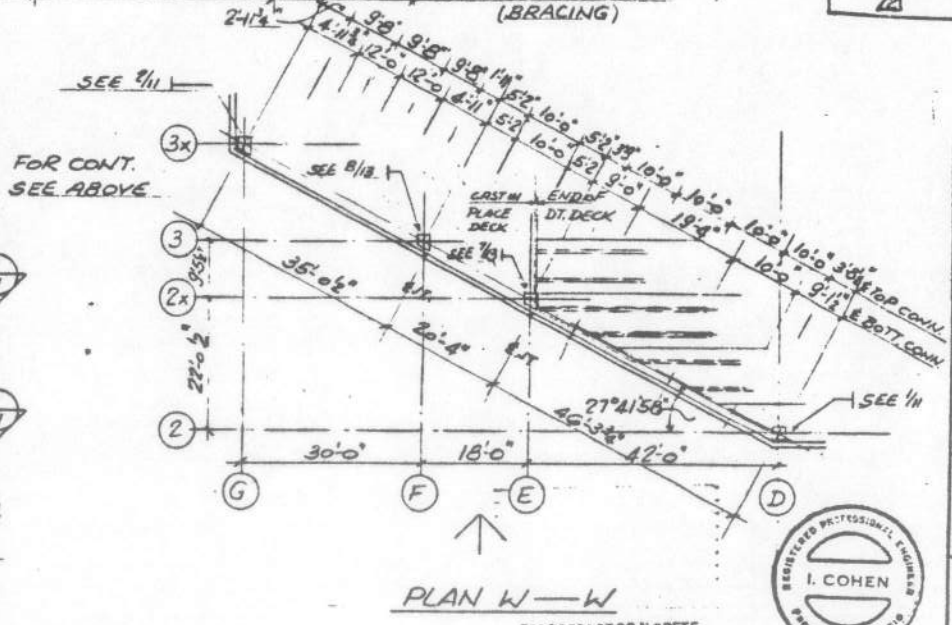

PLAN W—W

FOR PRECAST CONCRETE COMPONENTS AND THEIR CONNECTIONS AS SUPPLIED BY STANLEY STRUCTURES LIMITED ONLY

I. COHEN
REGISTERED PROFESSIONAL ENGINEER
PROVINCE OF ONTARIO

APPROVED
15 APR 80
CONSTRUCTION

RECEIVED
DEC 24
MARSHALL MACKLIN MONAGHAN LIMITED

REVISED
5. JUN. 1980

39 03

DATE	ISSUE	REV No	DESCRIPTION	CHECK
5.JUN.80	#5	2	ADD MARK Nos PLANTER	
6.MAY.80	#4	1	ADD MARK Nos	
15.APR.80	#3	-	ERECTION	
17.3.80	#3	GEN	RECORDS & JOBSITE	
25.2.80	#2	-	FOR RE-APPROVAL	
28.1.80	#1	-	FOR APPROVAL	

STANLEY
Stanley Structures Limited
Belleville (613) 962-4567

JOB
NORTH YORK GENERAL HOSPITAL PARKING DECK

DETAIL
PANEL ELEVATIONS

DETAIL NO.	DRN BY	CHK.	DATE
DETAIL REFERENCE SHEET NO. SHEET NO.		I.C.	JAN. 1980
	CHECKED BY		REVISION
	DRAWING NO.		D-3469-7

ERECTION NOTE:
ALL WELDED CONNECTIONS TO BE TOUCHED UP WITH GALVAFROID.

FINAL TOP CONN. 3-PER 27'-0" PANEL
6"LG. HEAVY DUTY INSERT CAST IN PANEL SUPPL. BY S.S.L
6"LG. SLOTTED INS. WITH 2"x⅝"x6" ℄ CAST IN BM. + 2½"x⅜" MILLED BAR WITH ⅜"x2½" SLOT
'L1'

TEMPORARY TOP CONN.
⅝"ϕ x 1'-6"LG. STD. BOLT 'SL10'
⅝"ϕ SPRING LOAD. NUT
NOTE: THIS CONN. REMOVED AFTER FINAL WELD IS MADE

#5 BAR x 4'-0"LG. @ 4'-0" c/c CAST IN PNL.

'L2' 4½"x½"x4½" NEOP. PAD ¾H 70 @ ¼ POINTS

'L3' 5"x¾"x3" PLASTIC SHIMS @ JOINTS

'L4' 4½"x¾"x4½" NEOP. PAD ¾H 70

'L5' 9"x⅝"x1'-10" NEOPRENE PAD ¾H 70

1"ϕ ECF2 INS. CAST IN COL.

BOTTOM CONN. 2-PER 27'-0" PANEL @ ¼ POINTS
¾"ϕ INS (GALV.) IN PANEL
4"ϕ PLASTIC PIPE THROU. BM.
'L6' ¾"ϕ GALV. ROD x 1'-10"LG
'L7' 5"x¼"x5" ℄ WASHER (GALV.)
¾"ϕ GALV. HEX NUT

'L8' 4"x⅜"x4" ℄ WASHER

'L9' 3"x⅜"x8" ℄

1"ϕ GALV. HEX NUT

3"x⅜"x10" ℄ c/w 3-⅝"ϕ N.S. CAST IN COL.

3"x⅜"x10" ℄ c/w 3-#5 x 2'-9" ANCH.S CAST IN BM.

'L15' 1"ϕ x 3'-6½"LG. THREAD. ROD (GALV.)

½" JOINT IN PANEL

2"x4" DUCT

ELEV. 'A' (c MIDLEVEL)

TEMPORARY BRACE 4'-6"

SAME CONN. AS SECT. 1
TOP CONN. @ 10'-0" c/c
'L4"x3"x¼"L x 4'-4⅜"LG (GALV.) WELD IN PLANT SECT. 2
#5 BARS x 4'-0"LG. @ 4'-0" c/c CAST IN PNL.

1-1"ϕ THREAD. ROD + 2 NUTS + 2 WASHERS
NOTE: FINGER TIGHT NUTS & TACK WELD TO ROD

'L11' 4"x3"x¼"L x 1'-11⅜"LG FOR SECT 2
'L44' x 2'-11¾"LG. FOR SECT 2A

'L45' 4"x3"x¼"L x 4'-8¾" FOR SECT 2A

#5-4'x3⅜"x8" CAST IN SLAB

'L4'

P.C. BEAM

℄ OF 8"ϕ HOLE BETWEEN LINE 7 & B

FOR CONN. @ COL. SEE SECT. 3/8

NOTE: BOTT. BRACING @ 20'-0" c/c MAX. WITH 2-PER PANEL

COL FINS SEE COL. LAYOUT FOR LOCATION

¾"x¾" REGLET AROUND COL'S

SECTION-'B'

'L12' 6"x⅝"x6" TOP ℄ (GALV) c/w STAINLESS STL. BOTT. FACE & ¾"x½"x5" PAD WITH TEFLON ON TOP FABREEKA

'L13' 9"x⅝"x1'-10" NEOPRENE PAD ¾H 70

'L14' 4"x6"x⅜" L x 4'-6" LG (GALV.) ON LOW SIDE OF DT. LEG.

1½" EXP. JT.

#6x⅜"x6" CAST IN BM. (GALV.) (1-PER 27'-0" BAY)

'L13' 1"ϕ x 3'-6½"LG. THREAD. ROD (GALV.) c/w 1"ϕ HEXNUT

1"ϕ ECF2 INSERT

FOR PRECAST CONCRETE COMPONENTS AND THEIR CONNECTIONS AS SUPPLIED BY STANLEY STRUCTURES LIMITED DATED

REGISTERED PROFESSIONAL ENGINEER I. COHEN PROVINCE OF ONTARIO

APPROVED
15 APR 80
CONSTRUCTION

RECEIVED
DEC 24
MARSHALL MACKLIN MONAGHAN LIMITED

39 04

15APR80	#3	-	ERECTION
17.3.80	#3	GEN	RECORDS & JOBSITE
25.2.80	#2	-	FOR RE-APPROVAL
28.1.80	#1	-	FOR APPROVAL
DATE	ISSUE	REV. No	DESCRIPTION / CHECK

STANLEY
Stanley Structures Limited
Belleville (613) 962-4567

JOB: NORTH YORK GENERAL HOSPITAL PARKING DECK

DETAIL: SECTIONS

DETAIL NO. | DRN. BY: KW | ENG.: I.C. | DATE: JAN. 80
CHECKED BY | REVISION
DETAIL REFERENCE SHEET NO. SHEET NO.
DRAWING NO. D-3469-8

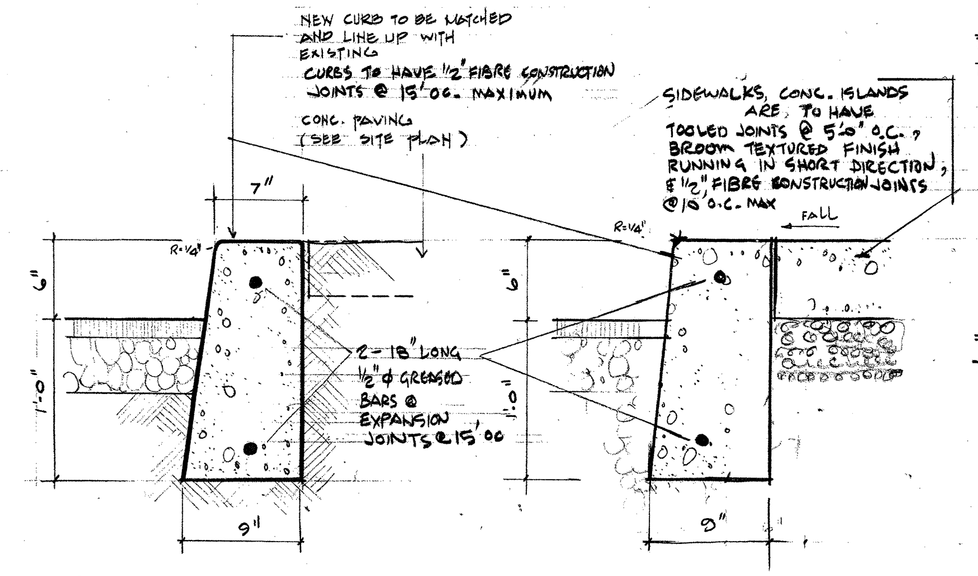

1 CONC. CURB

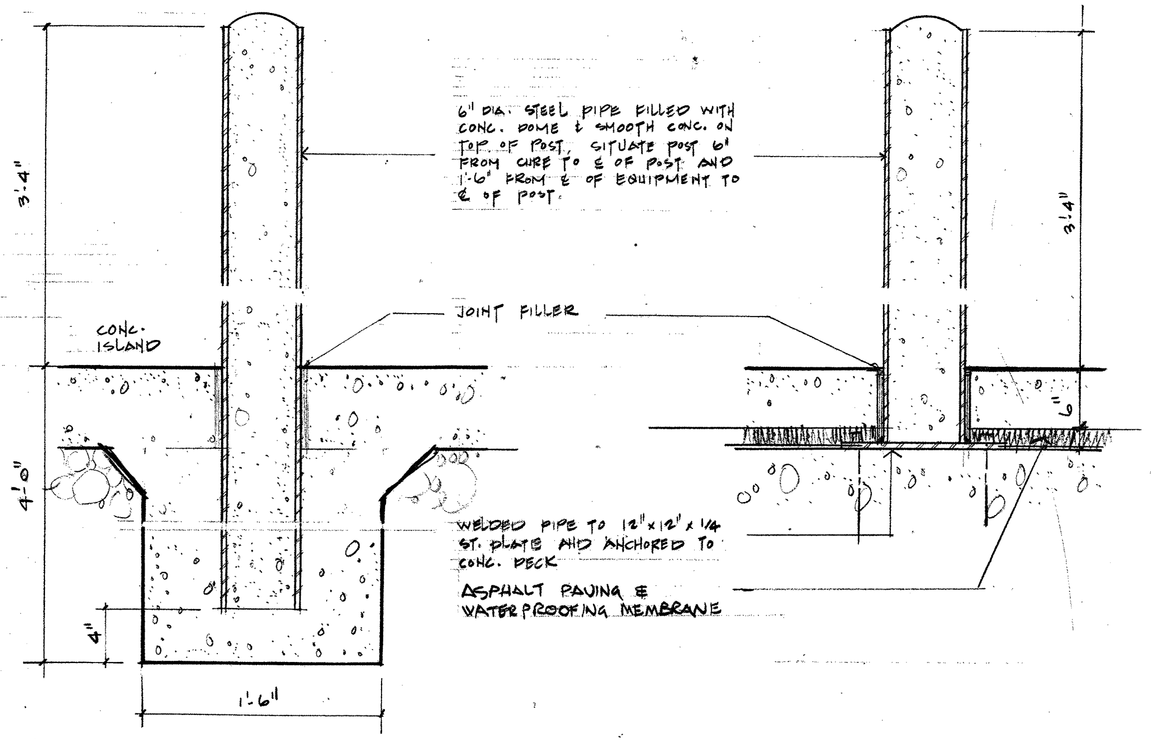

2 SIDEWALK & ISLAND CURB

3 BOLLARD - ON GROUND (16) PLUS TWO RELOCATED BOLLARDS SIMILAR

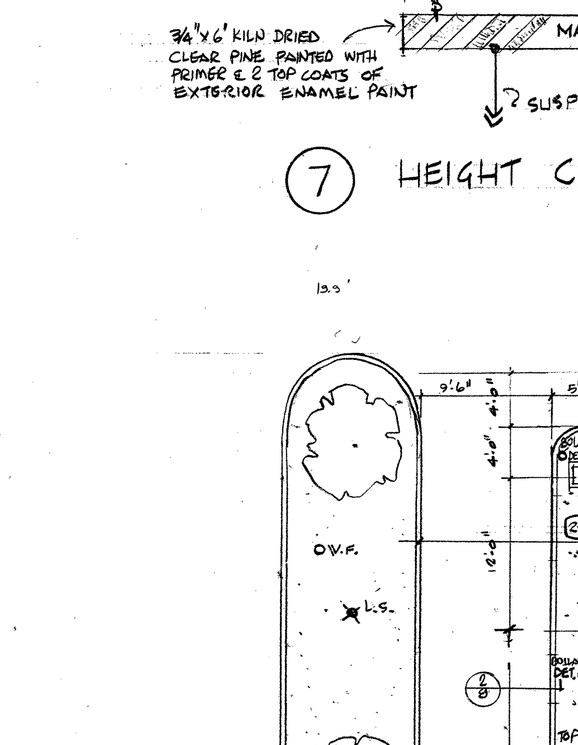

4 BOLLARD - on conc. DECK (2)

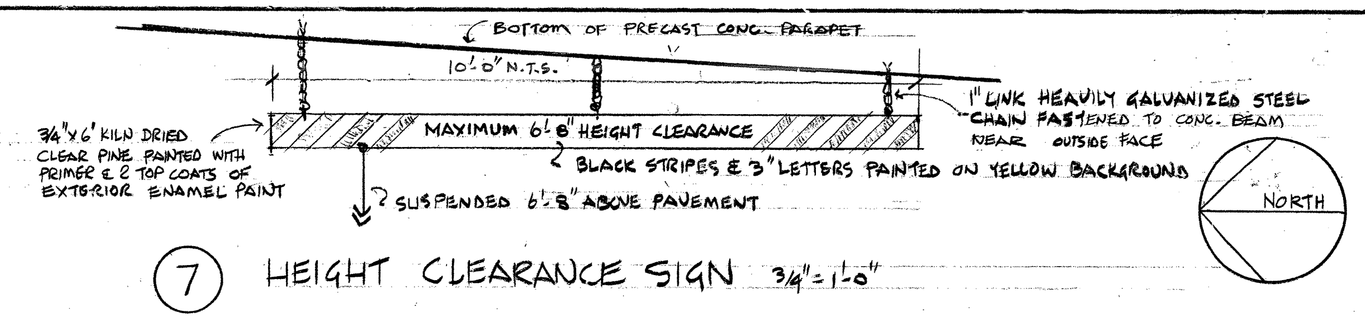

7 HEIGHT CLEARANCE SIGN 3¼"=1'-0"

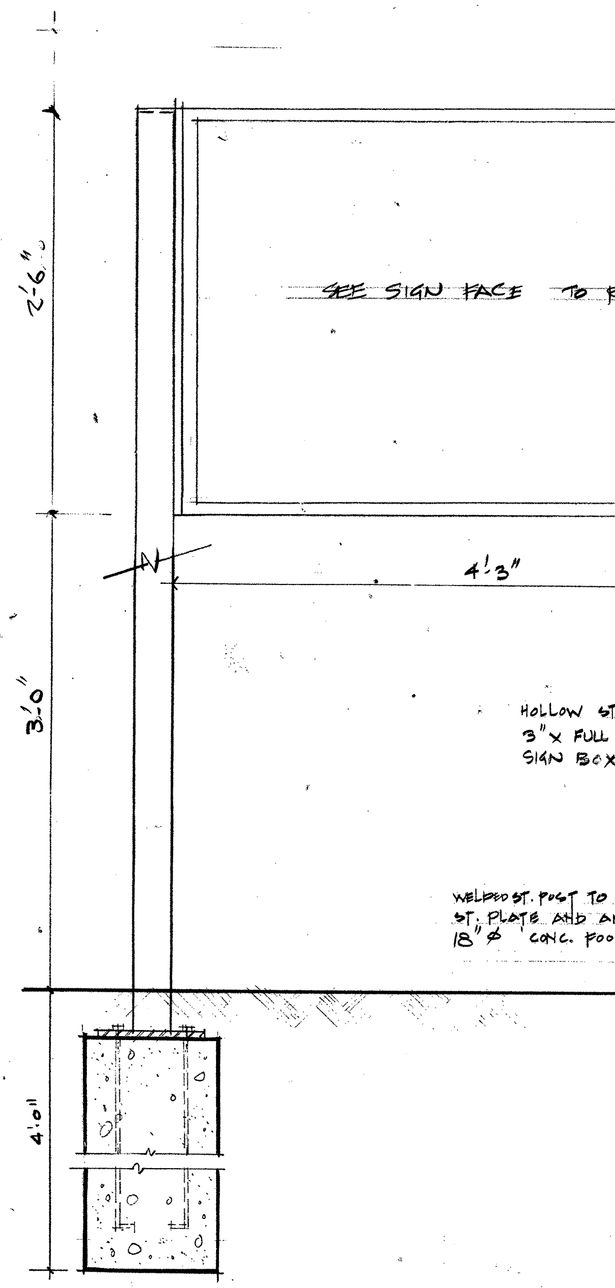

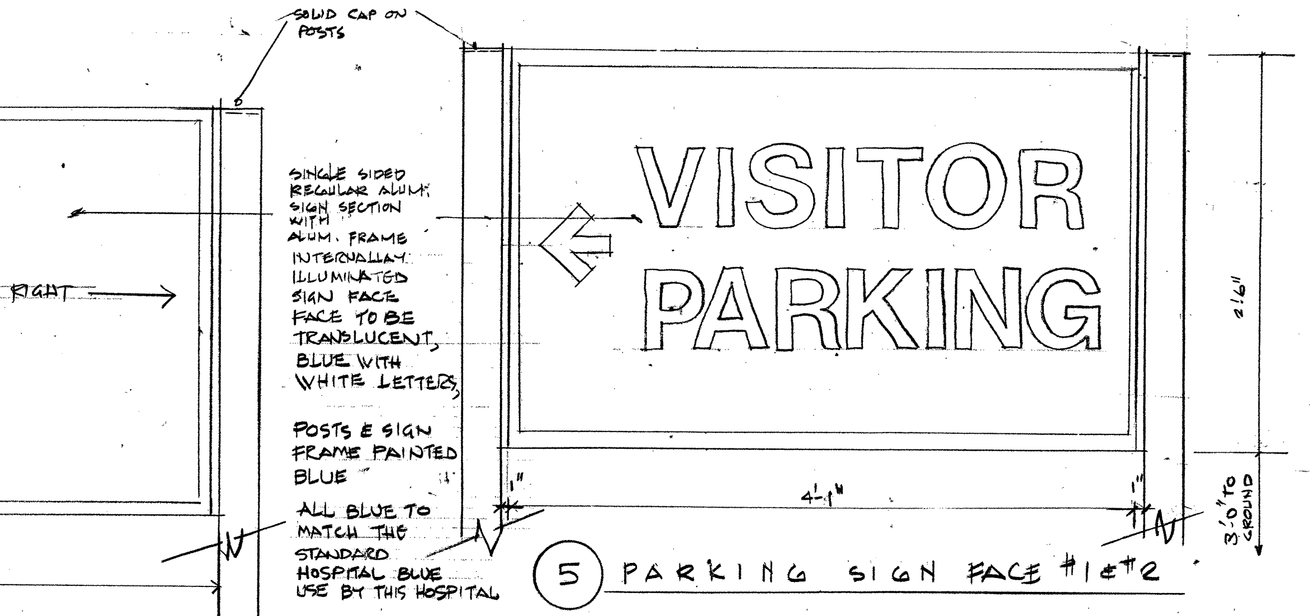

5 PARKING SIGN FACE #1 & #2

5 PARKING SIGN POSTS & BASE #1 & #2 1½"=1'-0"

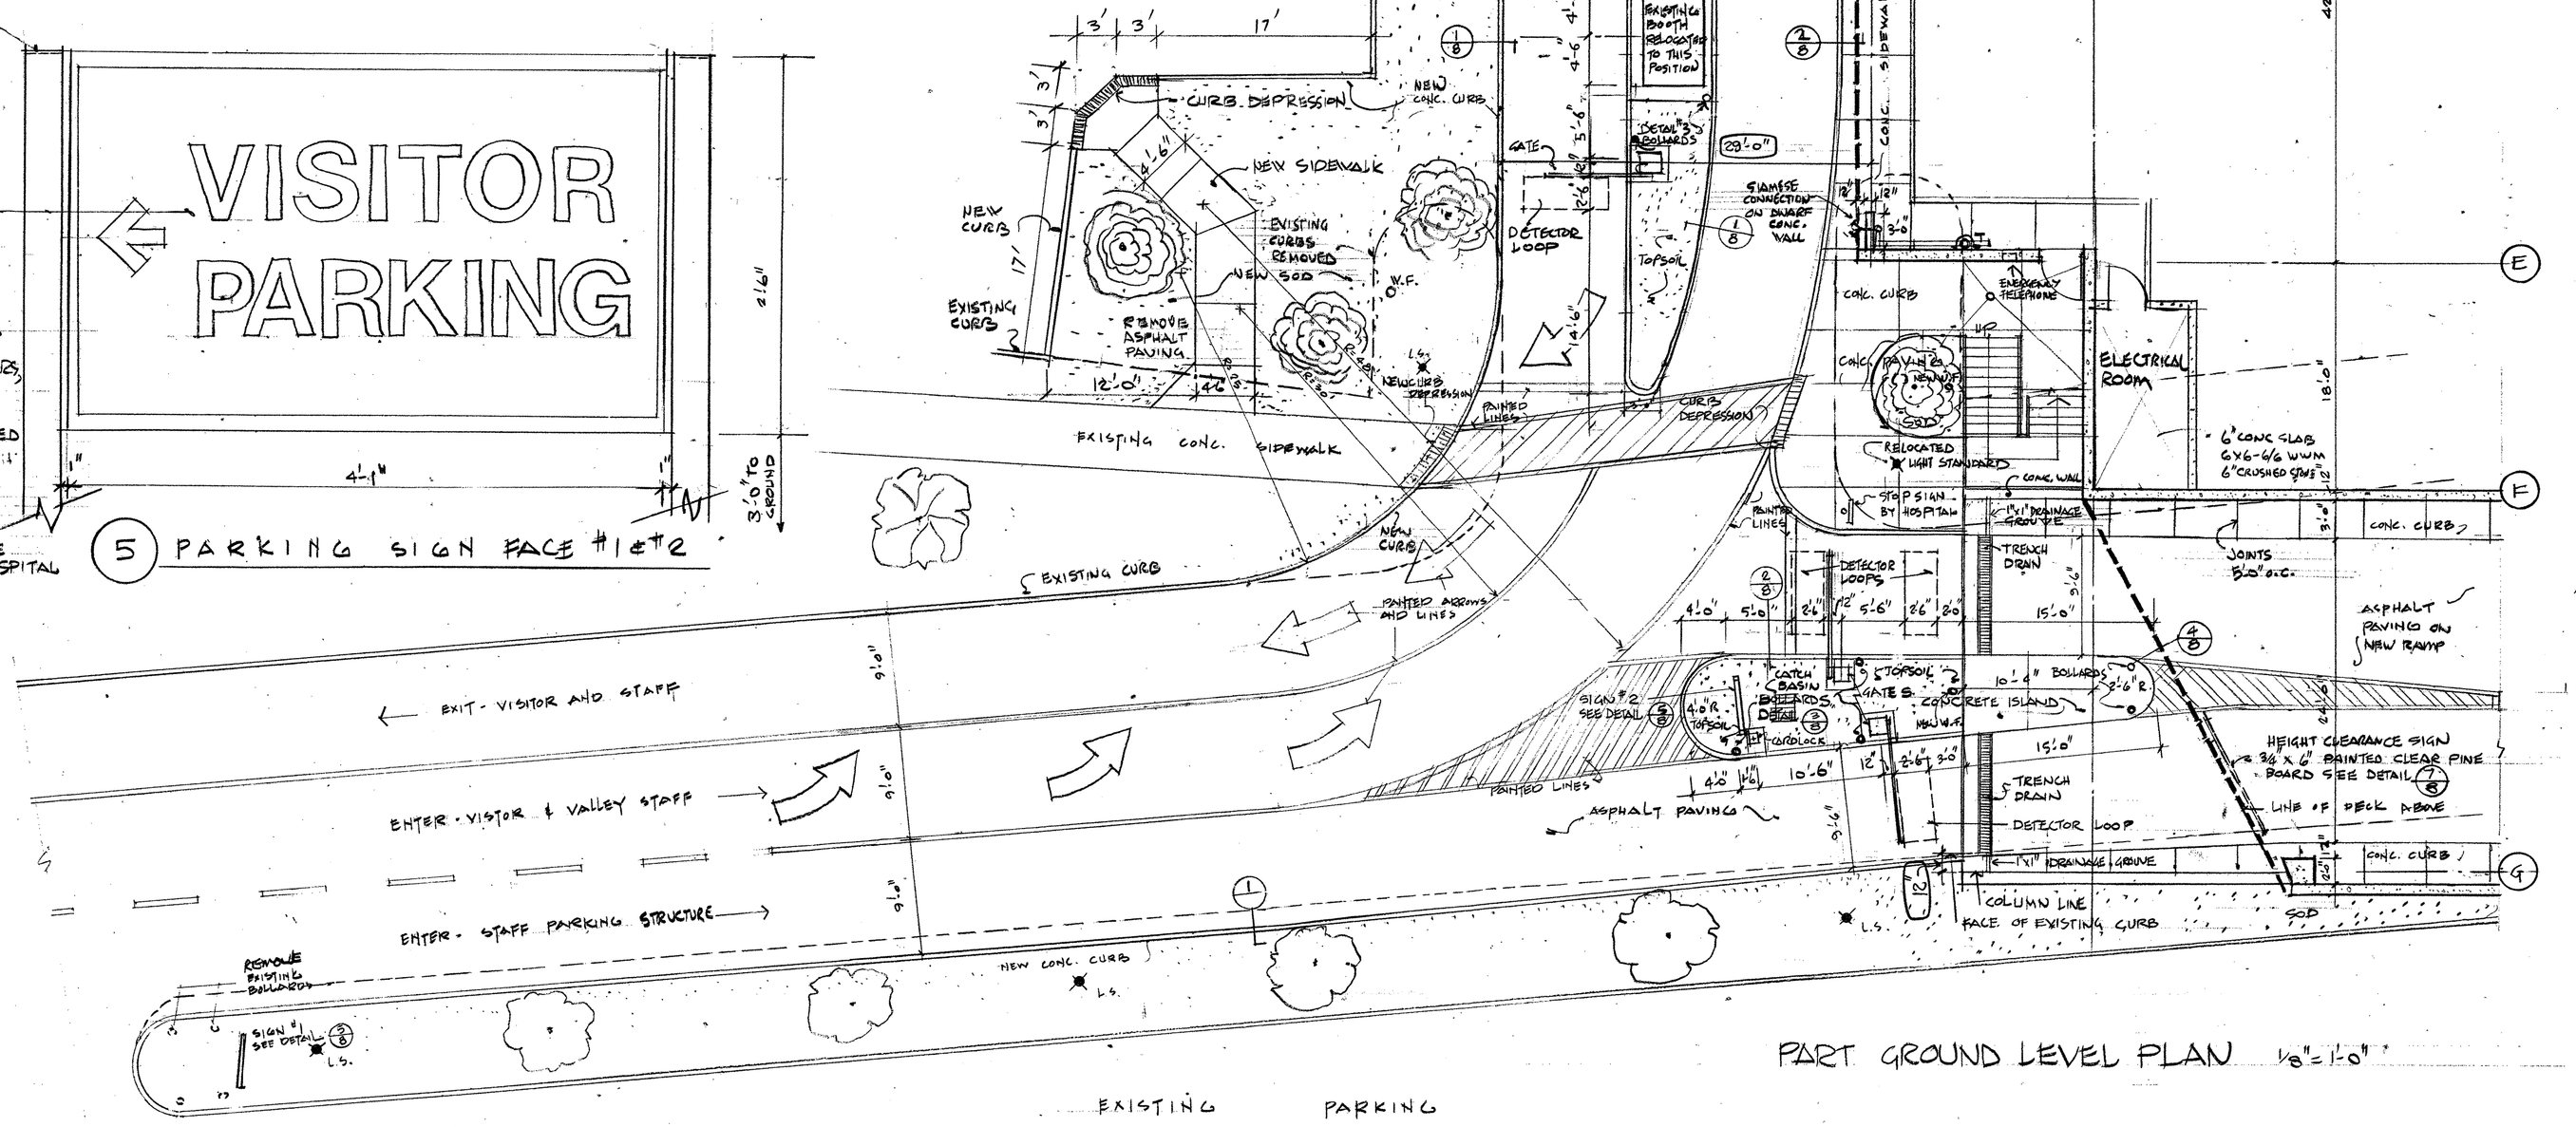

PART GROUND LEVEL PLAN 1/8"=1'-0"

No	DATE	DESCRIPTION	BY
2	DEC. 80	AS BUILT	
1	9 NOV. 79	ISSUED FOR TENDER	

Contractor to verify all dimensions on the job and report all errors before proceeding with the work

Deacon Arnett Murray and Rankin
Architects
313 Sheppard Avenue East
Agincourt, Ontario
M1T 3J7
Telephone (416) 491-1176

NORTH YORK GENERAL HOSPITAL
4001 LESLIE STREET, NORTH YORK
PARKING STRUCTURE

TRAFFIC CONTROL AND DETAILS

54/82

Scale: 1/8", 1/2"=1'-0" Date: NOVEMBER 1979
Drawn by: S.N. Checked by: JB
Project No. A78-137 Drawing No. # 8

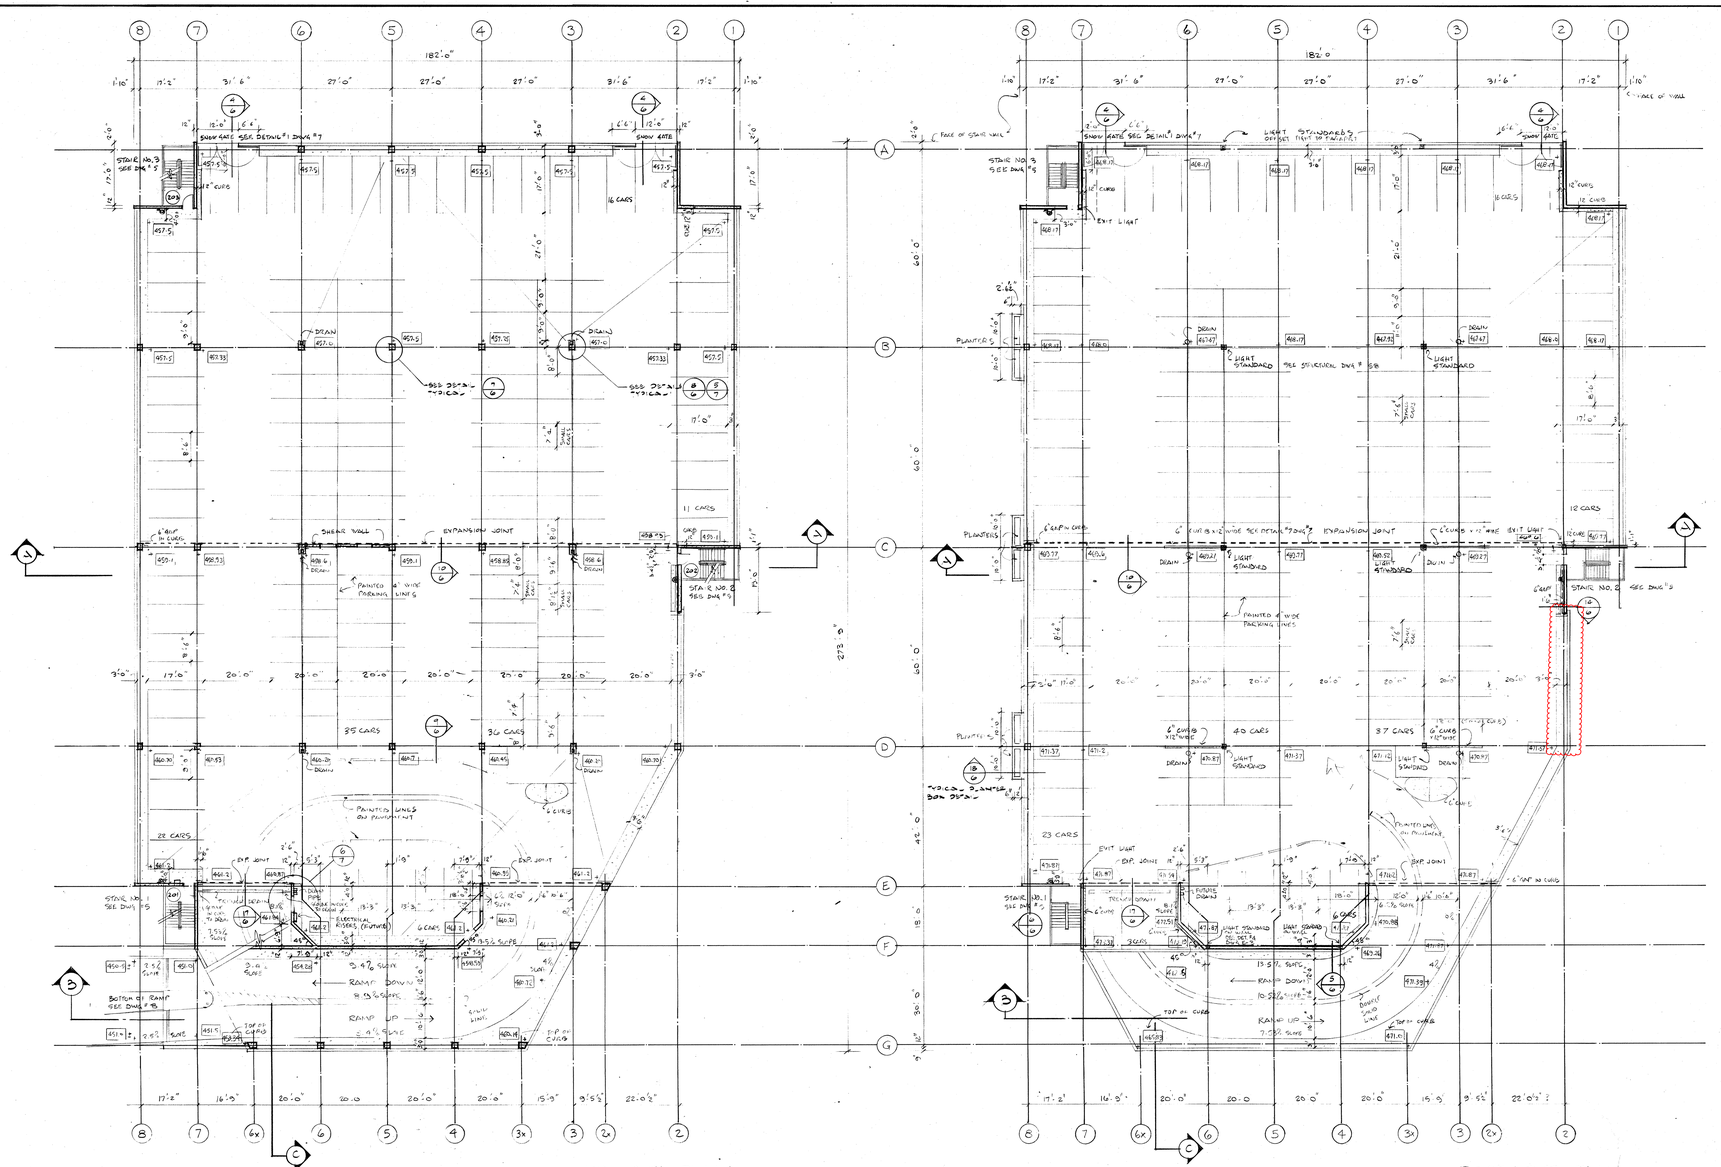

0.0 INDICATES FINISH DECK ELEVATIONS

NOTE: DECK IS TO SLOPE EVENLY TO DRAINS WITH NO PONDING

REFER TO DETAILS 3 & 4 ON DRAWING #7 FOR GROUTE & DETAIL WATERPROOFING & SEALANT LOCATIONS FOR MEMBRANE WATERPROOFING

NOTE: REFER TO RECORD PRECAST CONCRETE SHOP DRAWINGS FOR DECK & RAMP ELEVATIONS OF STRUCTURE AS BUILT AN AS BUILT SURVEY SHOULD BE TAKEN FOR CRITICAL ELEVATIONS FOR FUTURE EXPANSION - SUGGEST TO UNDERSIDE OF ROOF LEVEL BEAMS FOR REFERENCE.

No	DATE	DESCRIPTION	BY
2	DEC '87	AS BUILT	
1	19 NOV. 79	ISSUED FOR TENDER	

Contractor to verify all dimensions on the job and report all errors before proceeding with the work

Deacon Arnett Murray and Rankin
Architects
3131 Sheppard Avenue East
Agincourt, Ontario
M1T 3J7
Telephone (416) 491-1176

NORTH YORK GENERAL HOSPITAL
4001 LESLIE STREET, NORTH YORK
PARKING STRUCTURE

MID LEVEL PLAN
ROOF LEVEL PLAN

0493

Scale: 1/16" = 1'-0" Date: NOVEMBER 1979

Drawn by: JB Checked by: JE

Project NO. A78-137 Drawing NO. S 2